


SECTION 33 TOWNSHIP 18S RANGE 2W

WELL NO. #1 Larson

COMPANY Brunson Prod.

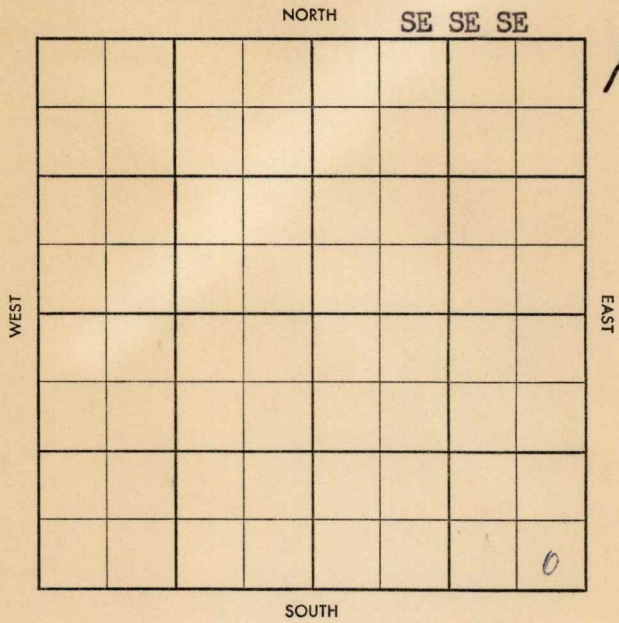

Top No Pool No
 Bottom No Pool No

5-513-B

County McPherson Elev. 15670 F 15700 B
 Sec. 33 Twp. 18 Rge. 2W
 Company Brunson Prod.
 Farm Name Larson No. 1

TOPS	DEPTH	LOG	DATUM
Anh.			
Tp.			
H.			
Tr.			
Dg.			
B.L.			
L.	<u>2362</u>		
K.C.			
B.K.C.			
Ce.			
C.			
M.	<u>2964</u>		
M.			
K.			
Mz.			
Mq.			
V.			
S.			
S.			
A.			
R.			
Pf.			
G.			
T.D.	<u>2980</u>		

Loc. in Sec. _____
SE SE SE
 Geol. _____
 Contr. _____
 Co. Tools _____
 Pool Larson Dis c
Wildcat

COMPLETE
 SEP 3 '58

Date Comm. 6-18-58
8" @ 95, Drlg. 2745. JUL 2 '58 DST 2964-80
1hr ga 108 met 270' clean oil
10' ocm BHP 580-500 FP 155-170
5" 2965 CO 2980 ga
200 met + spray JUL 9 '58 F10
2 Bopn 1/4 chh FCP 190 SI
JUL 23 '58 JUL 30 '58 wopot AUG 6 '58 AUG 13 '58 AUG 20 '58
AUG 27 '58 SEP 3 '58 Phy Flo 3130 pd NW
37 Miss

Co.
Lse.
No.
Sec.
T.
R.