


**KANSAS**Section 3 Township 18S Range 3WWell No. #1 FinneyCompany Texas Pacific C & O

NORTH

WEST

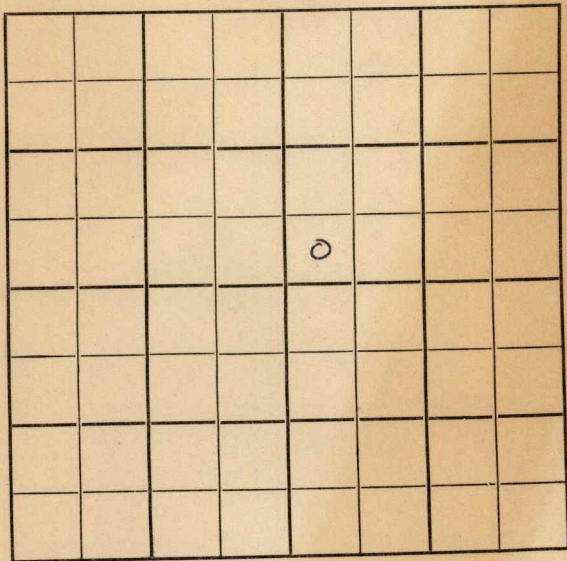

EAST

SOUTH

Sec. 3 Twp. 18 R. 3-W

Well No. #1 Finney Farm \_\_\_\_\_

Texas Pacific C&O Company

Wildcat


\_\_\_\_\_ Ft. from N. Line

330 Ft. from S. Line

\_\_\_\_\_ Ft. from E. Line

330 Ft. from W. Line

SW NE

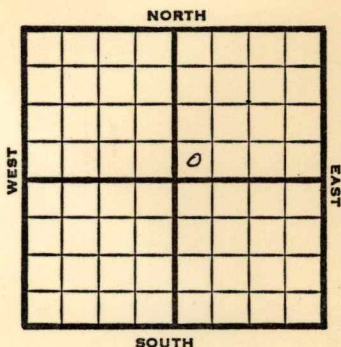

| 1949  | Elev 1452' REPORT |
|-------|-------------------|
| 10/12 | 8"@ 150'          |
| 10/19 | 10"@ 150'         |
|       | 8"@ 450'          |
|       | Drlg 989'         |
| 10/26 | Lansing 2446'     |
|       | Miss 3035'        |
|       | Drlg. 3125'       |
| 11/2  | TD 3716'          |
|       | Arb. 3694'        |
|       | Aband.            |
|       | <b>ABANDONED</b>  |

Map No. \_\_\_\_\_ Sec. 3 Twp. 18 R. 3W

Well No. 1 Finney

Texas Pacific C & O Company

Mallard Drlg. Contractor

SW NE


FIRST REPORT  
SECTION PLAT

\_\_\_\_\_ Ft. from N. Line

330 Ft. from S. Line

\_\_\_\_\_ Ft. from E. Line

330 Ft. from W. Line

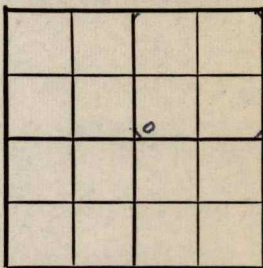

McPherson County

Location \_\_\_\_\_

Rig up \_\_\_\_\_

Drilling and Remarks:

8" @ 150

RECORD

Cased \_\_\_\_\_ in., \_\_\_\_\_ ft.

Sand \_\_\_\_\_

Gas \_\_\_\_\_

Oil \_\_\_\_\_

Total Depth \_\_\_\_\_

PRODUCTION

1st 24 hrs. Nat. \_\_\_\_\_

1st 24 hrs. after shot \_\_\_\_\_

Gas \_\_\_\_\_ Cu. Ft.

Dry Hole \_\_\_\_\_

Abandoned \_\_\_\_\_

Date

OCT 12 1949 19

S. J. LEWIS Scout


Kansas

Wildcat

Map No. \_\_\_\_\_ Sec. 3 Twp. 18 R. 3WWell No. 1 FinneyTexas Pacific C & O  
**ABANDONED** Company

SW NE

Contractor

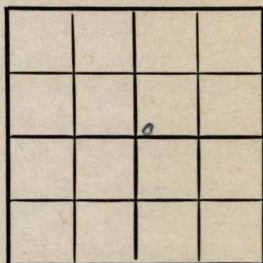*E1.1452.*  
**SECTION PLAT**

\_\_\_\_\_ Ft. from N. Line

330

\_\_\_\_\_ Ft. from S. Line

\_\_\_\_\_ Ft. from E. Line

330

\_\_\_\_\_ Ft. from W. Line

McPherson County

Location \_\_\_\_\_

Rig up \_\_\_\_\_

Drilling and Remarks:

*See 3694.***RECORD**

Cased \_\_\_\_\_ in., \_\_\_\_\_ ft.

Sand \_\_\_\_\_

Gas \_\_\_\_\_

Oil \_\_\_\_\_

Total Depth 2216**PRODUCTION**

1st 24 hrs. Nat. \_\_\_\_\_

1st 24 hrs. after shot \_\_\_\_\_

Gas \_\_\_\_\_ Cu. Ft.

Dry Hole \_\_\_\_\_

Abandoned \_\_\_\_\_

Date

NOV 2 1949 19S. J. LEWIS Scout