


Section 6 Township 18 Range 3W

Well No. 2 Landgren "A"

Company Rupp-Ferguson

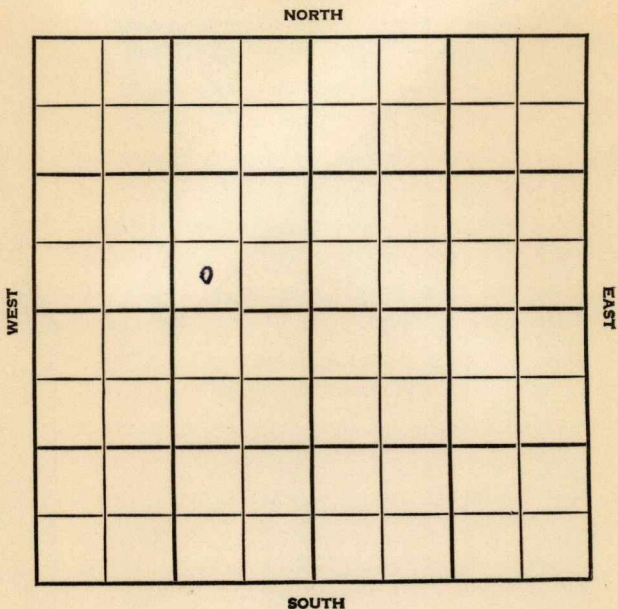

SEC.	TWP.	R.
6	18	3W

WELL NO. 2 Landgren "A" FARM

COMPANY Rupp-Ferguson

CONTRACTOR Co. Tools


SE Lindsborg Pool

_____ Ft. from N. Line

330 _____ Ft. from S. Line

990 _____ Ft. from E. Line

_____ Ft. from W. Line

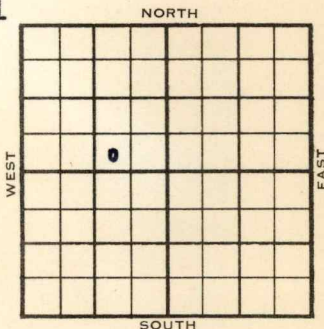

SW SE NW

1955	ELEVATION 1378'	REPORT
------	--------------------	--------

3/2 MIR

5/25 Miss 2943; Kind. 3184; Sylv Maq 3409;
 Viola 3463; Simp Sd 3523; TD 3528;
 13" 185; 8" 409;
 DST 3516-28 open 2 hrs, rec 120' co,
 30' muddy oily wtr. plus 120' sw,
 1070#; RTD 3528; 5" 3523; CO 3528;
 swb 1 1/2 bfph, est 40% wtr 6 hrs;
 pmp 10 bo 70 bwpd; Phy 37 bopd 50% wt
 from Simp 3523-28

COMPLETED

