

Form 51—5M—5-34—Palace

Map No. KANSAS Sec. 11 Twp. 10 R. 1

Well No. 1 Giverson Farm

Company

NORTH

WEST

EAST

SOUTH

Location_____

Drilling Remarks

Rig Up_____

Drilling Remarks

RECORD

Cased_____in. _____ft.

Sand

Gas

Oil_____

Total Depth.....

PRODUCTION

1st 24 hrs. Nat.-----

1st 24 hrs. after shot_____

Gas _____ cu. ft. _____

Dry Hole.....


Abandoned.....

McPherson

Map No. KANSAS Sec. 11 Twp. 18 R. 3W

Well No. 1 Svenson Farm
Tom Palmer Company

NORTH

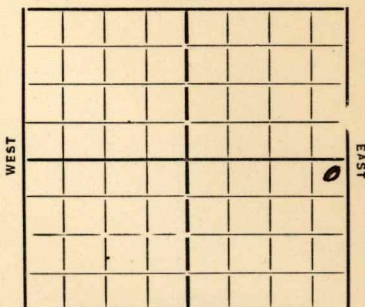

SOUTH

330 Ft. from N. Line

 Ft. from S. Line

330 Ft. from E. Line

 Ft. from W. Line

Date 1935

REPORT

2/6	Cellar	
2/14	Rgn	
2/21	Alg 555	15" 70
2/28	" 1100	
3/7	" 1360	
3/14	13" 1320	
3/21	Alg 1930	17" 1918
3/28	" 2145	10" 1996
4/4	HFW 2180	10" 2318
	TC 2370	Alg 2465
4/11	8" 2555	2620 UR 8"
4/18	HFW 2628-34	8" 2654
	HFW 2680-2700	UR 2725
4/26	8" 2772	Alg 3018
5/2	UR 8" 2850	T 17 3018
5/9	6" 3018	TC 3080 HFW 3100
	Alg 3105	
5/16	6" 3125	
5/23	HFW 3250	6" 3250 Alg 3340
5/29	6" 3340	BML 3360
	HFW 3642	Viola 3645
6/5	Viola 3625	T 2 3642 7.17

ABANDONED

KANSAS

Map No. 42 Sec. 11 Twp. 18 R. 3WWell No. 1-SwensonTom Palmer Company

Contractor

SECTION PLAT

330 Ft. from N. Line

Ft. from S. Line

330 Ft. from E. Line

Ft. from W. Line

			0

Location

Rig up

Drilling and Remarks:

cellar

RECORD

Cased _____ in., _____ ft.

Sand _____

Gas _____

Oil _____

Total Depth _____

PRODUCTION

1st 24 hrs. Nat. _____

1st 24 hrs. after shot _____

Gas _____ Cu. Ft.

Dry Hole _____

Abandoned _____

Date

2-6-35 192

ORVAL MANNSCHRECK

Scout

KANSAS

Map No. 412 Sec. 11 Twp. 18 R. 3WWell No. 1—SvensonTom Palmer Company

Contractor

ABANDONED

SECTION PLAT

330 Ft. from N. Line

Ft. from S. Line

330 Ft. from E. Line

Ft. from W. Line

			0

Location

Rig up

Drilling and Remarks:

RECORD

Cased _____ in., _____ ft.

Sand Viola 3625

Gas _____

Oil _____

Total Depth 3642

PRODUCTION

1st 24 hrs. Nat. _____

1st 24 hrs. after shot _____

Gas _____ Cu. Ft.

Dry Hole _____

Abandoned _____

Date

6-5-35 192 _____ Scout

ORVAL MANNSCHRECK