


Section 6 Township 18 Range 3W

Well No. #1 Landgren "B"

Company Rupp-Ferguson

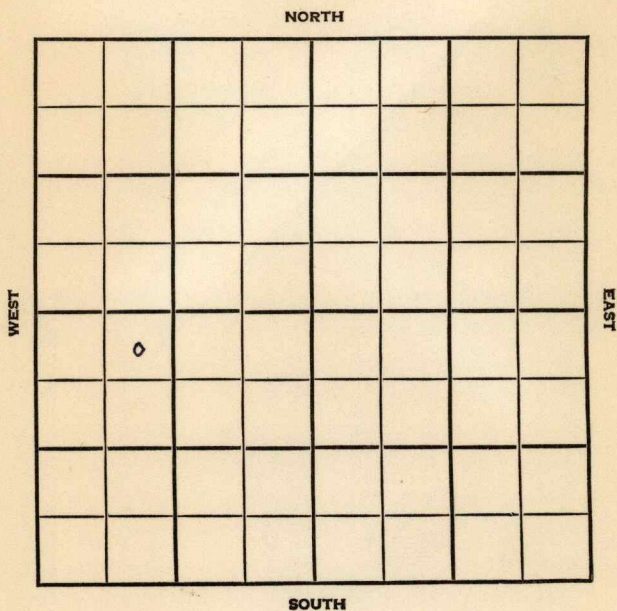


SEC.	TWP.	R.
6	18	3W

WELL NO. \_\_\_\_\_  
 COMPANY 1 Landgren "B" FARM

CONTRACTOR Rupp-Ferguson

Co. Tools  
 SE Lindsborg Pool

330 \_\_\_\_\_ Ft. from N. Line  
 \_\_\_\_\_ Ft. from S. Line  
 \_\_\_\_\_ Ft. from E. Line  
 990 \_\_\_\_\_ Ft. from W. Line

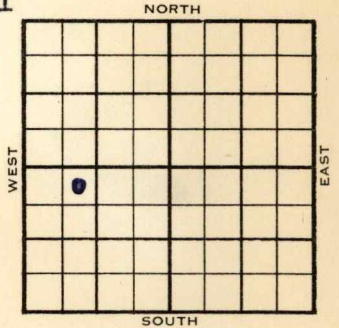

NE NW SW

	ELEVATION	REPORT
1955	1371'	

2/16 Spud 2-11-55  
 13" @ 140'  
 8" @ 410'  
 WOC

5/25 Miss 2934; Kind 3178; Misener 3391;  
 Sylv Maq 3400; Viola 3456; Simp sh  
 3511; Simp sd 3516; TD 3553;  
 13" 140; 8" 410; RTD 3553; 5" 3549½;  
 CO; 16/3519-23; swb 1 boph 3 hrs;  
 250 A; swb 1½ boph plus 40 bw;  
 pmp 35 bo plus 40 bwpd; Phy 28 bopd  
 80% wtr from Simp 3519-23

COMPLETED

