


Section 6 Township 18 Range 3W

Well No. #1 Peterson

Company Rupp-Ferguson

NORTH

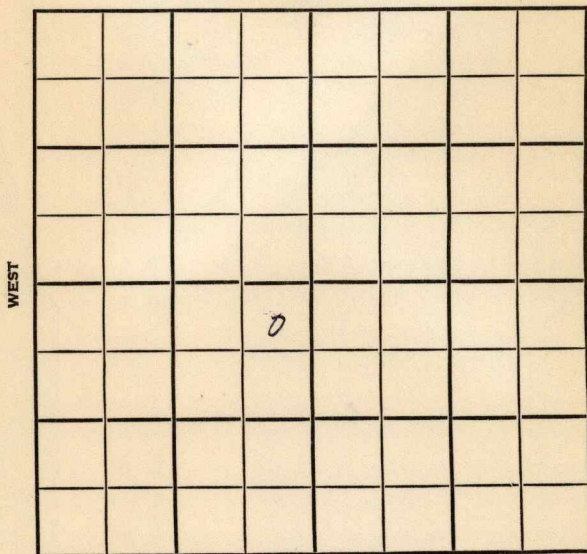

SOUTH

SEC.	TWP.	R.
6	18	3W

WELL NO. **1 Peterson** FARM

COMPANY **Rupp-Ferguson**

CONTRACTOR **Co. Tools**


S. Lindsborg Pool

330 Ft. from N. Line

_____ Ft. from S. Line

330 Ft. from E. Line

_____ Ft. from W. Line

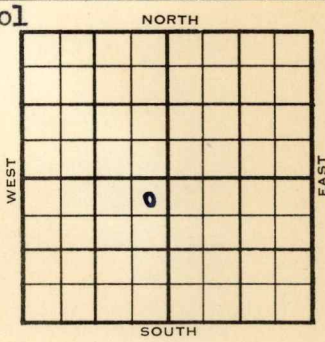

NE NE SW

	ELEVATION	REPORT
1955	1394'	

3/23

Spud 3-18-55
 13" @ 180'
 8" @ 432'
 Drlg. 2040'

4/6

Spud 3-18-55, D&A, TD 3549,
 13" @ 180, 8" @ 432, Miss 2959,
 Kh. 3202, Maq. 3428, Viola 3482
 Simp sh. 3540, Simp sd 3547
 DST 3546-49 open 1 hr Rec 40' o
 oil, 370' SW 1015#
 TD 3549
 D&A

ABANDONED

County **McPherson** State **Kansas**

Sec. **6** (Blk. Twp.) **18** (Sur. Rge.) **3W** Map No.

Operator **Rupp-Ferguson**

Well No. **1** Farm **Peterson**

Elev. **1394** Location **NE NE SW**



330 Ft. From **N** Line **SW**

330 Ft. From **E** Line **Quarter**

1st. Report **MAR 23 1955**

Completion

Remarks

Co. tools

Spudding Date **3-18-55**

Drlg. Data **S. Lindsborg Pool**

13" @ 180 8" @ 432 drlg. 2040

FABEN GILSTRAP

County McPherson State Kansas

Sec. 6 (Blk.) 18 (Sur. Rge.) 3W Map No.

Operator Rupp-Ferguson

Well No. 1 Farm Peterson

Elev. 1394 Location NE NE SW



330 Ft. From N Line SW

330 Ft. From E Line Quarter

1st. Report

Completion APR 6 1955

Remarks S. Lindsborg Pool Co. tools

Spudding Date 3-18-55

Drlg. Data D & A TD 3549

13" @ 180 8" @ 432 Miss. 2959

Kh. 3202 Maq. 3428 Viola 3482

Simp. sh. 3540 Simp. sd. 3547

DST 3546-49 open 1 hr. Rec. 40' oil

370' sw 1015# TD 3549

D & A

FABEN GILSTRAP