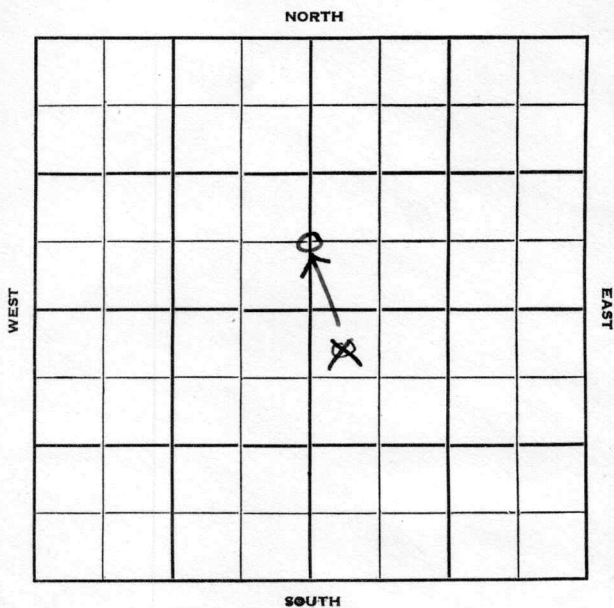


Section 5 Township 20 Range 11WWell No. #2 SoekenCompany Duke & Wood

Barton KANSAS

Sec. 5 Twp. 20 R. 11 W

Well No. # 2 Soeken Farm

Duke & Wood Company

Duke & Wood Contractor

2310

330 Ft. from N. Line

_____ Ft. from S. Line


_____ Ft. from E. Line

2640

330 Ft. from W. Line

~~NW NW SE~~

C S/2 S/2 N/2

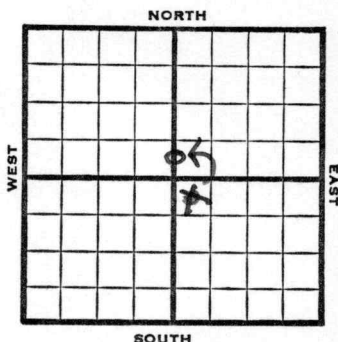

1952 Elev. 1778' REPORT

5/21 Spud 5-18-52
8" @ 202
Anhy 522'
Drlg. 998'
5/28 Heeb. 2926 Br Li 3050
Lans. 3069
Drlg. 3150'
6/11 RTD 3316' 5" @ 3314 DD 3323' TD
500 A
6/18 4500 A S/3 BOPH PB 3190
24/3149-52 500 A Fill up 1710
fluid mostly wtr.
6/25 S/ 3 Boph & 1 Bwph POP
7/2 NR
7/9 NR
7/17 P/90 BOPD. decreased to 26 BOPD
7/23 NR
7/30 Spud 5-18-52
Oil Well TD 3323 8" @ 202'
Anhy 522 Heeb. 2926
Br Li 3050 Lans. 3069
DST 3136-56 openlhr rec. 300' gas
120' O&GCM 150' HO&GCM 60' sw
990# DST 3237-49 open 22 min.
rec. 28' mud 0# Arb. 3313 TD 3316
5" @ 3314' DD 3323 500 A 4500A

OVER


1952

7/30

FU 1710' fluid mostly wtr. S/3 boph
1 bw P/ 90 bopd dec. to 26 bopd
Comp. 19 bopd 12 bw

COMPLETED

County **Barton** State **Kansas**
 Sec. **5** (Blk.) **20** (Sur.) **11W** Map No.
 (Twp.) (Rge.)
 Operator **Duke & Wood**
 Well No. **2** Farm **Soeken**
 Elev. Location **NW NW SE**

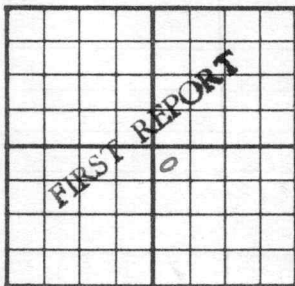

330 Ft. From **N** Line **SE**

330 Ft. From **W** Line Quarter

1st. Report **MAY 21 1952**

Completion

Remarks

Duke & Wood - Contr.

Spudding Date **5-18-52**

Drlg. Data


8" @ 202 Anhy 522 Drlg. 998

J. G. McGEHEE

KANSASMap No. _____ Sec. 5 Twp. 20 R. 11WWell No. 2 SoekenDuke & Wood

Company

Contractor

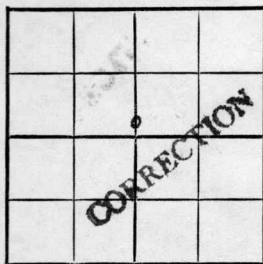C $S\frac{1}{2}$ $S\frac{1}{2}$ $N\frac{1}{2}$ **SECTION PLAT**2310 Ft. from N. Line

_____ Ft. from S. Line

_____ Ft. from E. Line

2640 Ft. from W. LineBarton County

Location _____

Rig up _____

Drilling and Remarks:

Reported

NW NW SE

RECORD

Cased _____ in., _____ ft.

Sand _____

Gas _____

Oil _____

Total Depth _____

PRODUCTION

1st 24 hrs. Nat. _____

1st 24 hrs. after shot _____

Gas _____ Cu. Ft.

Dry Hole _____

Abandoned _____

Date


MAY 28 1952

19

J. G. McGEHEE

Scout

County Barton State Kansas
 Sec. 5 (Blk. 20 (Sur. 11W Map No.
 Operator Duke & Wood
 Well No. 2 Farm Soeken
 Elev. 1778 Location C S L S $\frac{1}{2}$ N $\frac{1}{2}$

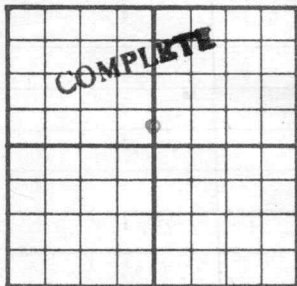

2310 Ft. From N Line Sec.
2640 Ft. From W Line Quarter
 Ist. Report
 Completion JUL 30 1952
 Remarks
Duke & Wood - Contr.
 Spudding Date 5-18-52

Drlg. Data Oil well TD 3323
8" @ 202 Anhy 522 Heeb. 2926
Br. lime 3050 Lans. 3069 DST 3136-56
open 1 hr. Rec. 300' gas 120' o & gcm
150' ho & gcm 60' sw 990# DST 3237-49
open 22 min. Rec. 28' mud 0#
Arb. 3313 TD 3316 5" @ 3314 DD 3323
500 A 4500 A S/ 3 boph PB 3190
24/ 3149-52 500 A FU 1710' fluid
mostly water S/ 3 boph 1 bw P/ 90 bopd
dec. to 26 bopd Comp. 19 bopd 12 bw

J. G. McGEHEE