


*McPherson*

Map No. *Ks* Sec. *22* Twp. *18* R. *3 W*  
 Well No. *1- Hanson* LOG Farm  
~~*McLaughlin et al*~~ Company  
*J.C. FINDIESS* <sup>NORTH</sup> *ETAL*

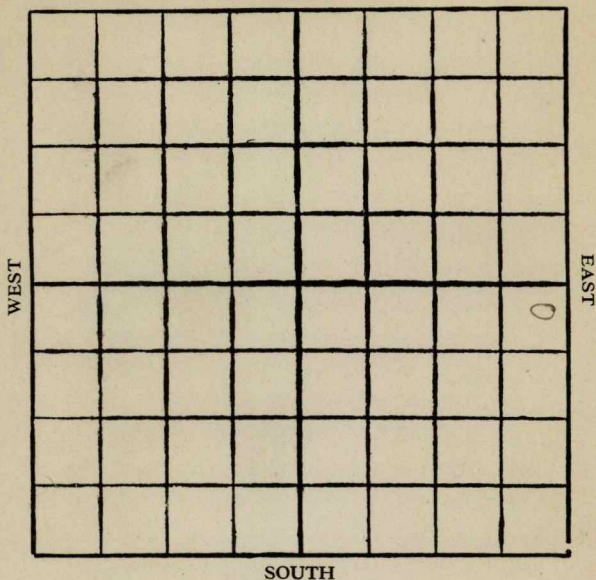

Location .....

Drilling Remarks

Rig Up .....

Drilling Remarks

RECORD

d in. ft.

PRODUCTION

1st 24 hrs. Nat. ....

1st 24 hrs. after shot .....

Gas ..... cu. ft.

Dry Hole .....

Abandoned .....

Oil  
Total Depth

McPherson

Map No. Kans Sec. 22 Twp. 18 R. 3 W.Well No. 1 - Hanson Farm~~McLaughlin et al~~ Company

J. C. Fendless


NORTH

300 Ft. from N. Line

\_\_\_\_\_ Ft. from S. Line

300 Ft. from E. Line

\_\_\_\_\_ Ft. from W. Line

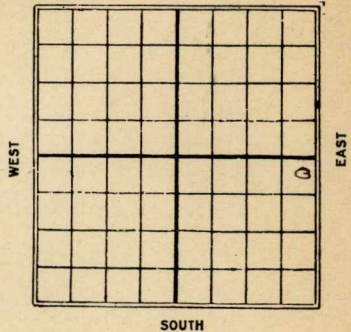1926

Date

REPORT

|              |                                   |
|--------------|-----------------------------------|
| <u>11/3</u>  | <u>location</u>                   |
| <u>11/10</u> | <u>same</u>                       |
| <u>11/17</u> | <u>same</u>                       |
| <u>11/24</u> | _____                             |
| <u>12/1</u>  | _____                             |
| <u>12/8</u>  | _____                             |
| <u>12/15</u> | _____                             |
| <u>12/21</u> | <u>moving in tool &amp; rigs</u>  |
| <u>12/29</u> | <u>log and tools</u>              |
| <u>1927</u>  |                                   |
| <u>1/5</u>   | <u>Rig bldg</u>                   |
| <u>1/12</u>  | <u>Rigging up</u>                 |
| <u>1/19</u>  | _____                             |
| <u>1/26</u>  | _____                             |
| <u>2/2</u>   | <u>spud</u>                       |
| <u>2/9</u>   | _____                             |
| <u>2/16</u>  | <u>spud 170</u>                   |
| <u>2/23</u>  | <u>T.D. 307 - str. reaming</u>    |
| <u>3/2</u>   | <u>Drlg 900</u>                   |
| <u>3/9</u>   | <u>" 1500</u>                     |
| <u>3/16</u>  | <u>T.D. 1530 - S.D.</u>           |
| <u>3/23</u>  | <u>T.D. 1530 - Drlg up cement</u> |

3/30 - Drlg 1790  
 4/6 - T.D. 1800 - U.R. 10"  
 4/13 - T.D. 1940 - U.R. 10"  
 4/20 - Drlg 2240  
 4/27 - T.D. - 2510 - U.R. 8"  
 5/4 - Drlg  
 5/11 - Drlg 2740  
 5/18 - " 2760  
 5/25 - " 2805  
 6/1 - " 2865  
 6/8 - " 3084  
 6/15 - Top chat 3133 - water 3148  
 Drlg 3215 -  
 6/22 - Drlg 3395 - H.F.W.  
 6/29 - Running 5" @ 3406 -  
 7/3 - T.D. 3500 (measured by  
 S.J. Lewis -)  
 7/13 - D. & A. 3630

*McPherson*  
 Map No. KANSAS Sec. 22 Twp. 18 R. 34

Well No. 1 Hanson

McLaughlan & Co. Company  
 Contractor

## SECTION PLAT

300 Ft. from N. Line

\_\_\_\_\_ Ft. from S. Line

300 Ft. from E. Line

\_\_\_\_\_ Ft. from W. Line

|  |  |  |   |
|--|--|--|---|
|  |  |  |   |
|  |  |  |   |
|  |  |  | 0 |
|  |  |  |   |

## FIRST REPORTS

Location \_\_\_\_\_

Rig up \_\_\_\_\_

Drilling and Remarks:

*Location.*

## RECORD

Cased \_\_\_\_\_ in., \_\_\_\_\_ ft.

Sand \_\_\_\_\_

Gas \_\_\_\_\_

Oil \_\_\_\_\_

Total Depth \_\_\_\_\_

## PRODUCTION

1st 24 hrs. Nat. \_\_\_\_\_

1st 24 hrs. after shot \_\_\_\_\_

Gas \_\_\_\_\_ Cu. Ft.

Dry Hole \_\_\_\_\_

Abandoned \_\_\_\_\_

Date

NOV 3 1926

S. J. LEWIS

Scout

Map No. 18 Sec. 22 Twp. 18 R. 34Well No. 1 HansonJ. C. Findliess & Co. Company

Contractor

## SECTION PLAT

300 Ft. from N. Line

Ft. from S. Line

300 Ft. from E. Line

Ft. from W. Line

|  |  |  |   |
|--|--|--|---|
|  |  |  |   |
|  |  |  |   |
|  |  |  | 0 |
|  |  |  |   |

Correction

Location

Rig up

Drilling and Remarks:

J. C. Findliess  
has taken this  
block over from  
Mc Laughlin & Co.

## RECORD

Cased \_\_\_\_\_ in., \_\_\_\_\_ ft.

Sand \_\_\_\_\_

Gas \_\_\_\_\_

Oil \_\_\_\_\_

Total Depth \_\_\_\_\_

## PRODUCTION

1st 24 hrs. Nat. \_\_\_\_\_

1st 24 hrs. after shot \_\_\_\_\_

Gas \_\_\_\_\_ Cu. Ft.

Dry Hole \_\_\_\_\_

Abandoned \_\_\_\_\_

Date

DEC 15 1926

192

S. J. LEWIS

Scout

MAP NO. KANSAS SEC. 22 TWP. 18S R. 3W

WELL NO. 1/Hanson

Alison - Ditzwillers COMPANY

CONTRACTOR

## SECTION PLAT

|  |  |  |   |
|--|--|--|---|
|  |  |  |   |
|  |  |  |   |
|  |  |  | 0 |
|  |  |  |   |

\_\_\_\_\_ FT. FROM N. LINE

\_\_\_\_\_ FT. FROM S. LINE

\_\_\_\_\_ FT. FROM E. LINE

\_\_\_\_\_ FT. FROM W. LINE

LOCATION \_\_\_\_\_

RIG UP \_\_\_\_\_

DRILLING AND REMARKS:

*chains  
with our  
map*

## RECORD

CASED \_\_\_\_\_ IN. \_\_\_\_\_ FT.

SAND \_\_\_\_\_

GAS \_\_\_\_\_

OIL \_\_\_\_\_

TOTAL DEPTH 3630

## PRODUCTION

1ST 24 HRS. NAT. \_\_\_\_\_

1ST 24 HRS. AFTER SHOT \_\_\_\_\_

GAS \_\_\_\_\_ CU. FT.

DRY HOLE ☒

ABANDONED ☒

DATE

7/12

192

7

SCOUT

Map No. KANSAS Sec. 22 Twp. 18 R. 3W

Well No. 1 Hanson

J.C. Findless & Co. Company

Contractor

### SECTION PLAT

300 Ft. from N. Line

\_\_\_\_\_ Ft. from S. Line

300 Ft. from E. Line

\_\_\_\_\_ Ft. from W. Line

**ABANDONED**

|  |  |  |   |
|--|--|--|---|
|  |  |  |   |
|  |  |  |   |
|  |  |  | 0 |
|  |  |  |   |

Location \_\_\_\_\_

Rig up \_\_\_\_\_

Drilling and Remarks:

7113630

DYA

### RECORD

Cased \_\_\_\_\_ in., \_\_\_\_\_ ft.

Sand \_\_\_\_\_

Gas \_\_\_\_\_

Oil \_\_\_\_\_

Total Depth \_\_\_\_\_

### PRODUCTION

1st 24 hrs. Nat. \_\_\_\_\_

1st 24 hrs. after shot \_\_\_\_\_

Gas \_\_\_\_\_ Cu. Ft.

Dry Hole \_\_\_\_\_

Abandoned \_\_\_\_\_

Date

JUL 13 1927

192

S. J. LEWIS

Scout