


Map No. **KANSAS** Sec. 25 Twp. 18 R. 3W
 Well No. 1- Rolander Farm
Yonker et al Company

NORTH

WEST

EAST

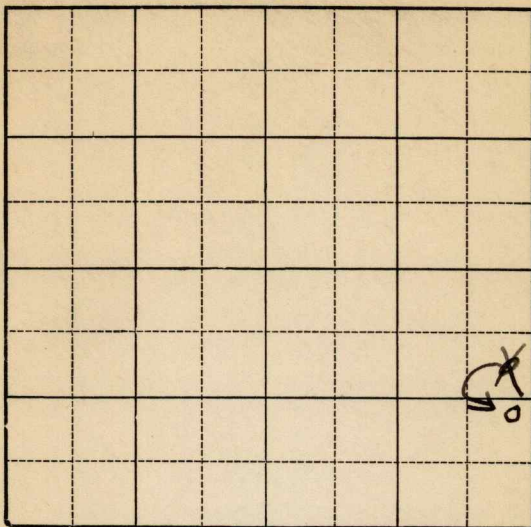

SOUTH

Location _____

Drilling Remarks _____

Rig Up _____

Drilling Remarks _____

RECORD

Cased _____ in. _____ ft.

Sand _____

Gas _____

Oil _____

Total Depth _____

PRODUCTION

1st 24 hrs. Nat. _____

1st 24 hrs. after shot _____

Gas _____ cu. ft.

Dry Hole _____

Abandoned _____

Mr Pherson

Map No. KANSAS Sec. 25 Twp. 18 R. 3W


Well No. 1- Rolander Farm
Yonker et al Company

990 Ft. from N. Line

990 Ft. from S. Line

330 Ft. from E. Line

_____ Ft. from W. Line

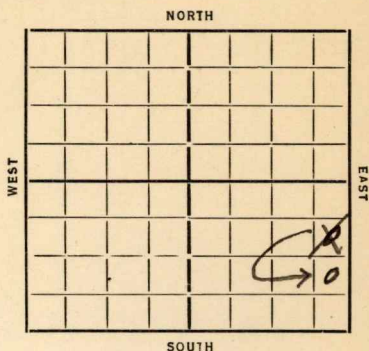

Date 7/25

REPORT

4/24 Rig
5/2 5/9 - 5/16
5/23 Moving
5/29 Run
6/6 6/13
6/20 Dlg 330
6/28 12" 1082 Dlg
7/3 Dlg 1680 10" 1580
7/11 8" 2075 6" 2320
2380 Run 5"
7/18 AC 2410
T' 2460
J. & F.

ABANDONED

Map No. 47 Sec. 25 Twp. 18 R. 3WWell No. 1- RolanderSpanker et al Company

Contractor

FIRST REPORT

SECTION PLAT

990 Ft. from N. Line

Ft. from S. Line

330 Ft. from E. Line

Ft. from W. Line

			0

Location

Rig up

Drilling and Remarks:

RECORD

Cased in., ft.

Sand

Gas

Oil

Total Depth

PRODUCTION

1st 24 hrs. Nat.

1st 24 hrs. after shot

Gas Cu. Ft.

Dry Hole

Abandoned

Date

4-24-35 192

ORVAL MANNSCHRECK

Scout

KANSAS

Form 26—1M/3ks. 9 28

Map No. 42 Sec. 25 Twp. 18 R. 3WWell No. 1- RolandYonker Company

Contractor

CORRECTION

Ft. from N. Line

990 Ft. from S. Line330 Ft. from E. Line

Ft. from W. Line

CORRECTION

SECTION PLAT

Location

Rig up

Drilling and Remarks:

formerly Reported
as D E N E D

RECORD

Cased.....in.,ft.

Sand.....

Gas.....

On.....

Total Depth.....

PRODUCTION

1st 24 hrs. Nat.....

1st 24 hrs. after shot.....

Gas.....Cu. Ft.

Dry Hole.....

Abandoned.....

Date

5-8-35 192

ORVAL MANNSCHRECK

Scout

Map No. 42 Sec. 25 Twp. 18 R. 3W

Well No. 1- Roland

Yankee et al Company

Contractor

ABANDONED

SECTION PLAT

Ft. from N. Line

990 Ft. from S. Line

330 Ft. from E. Line

Ft. from W. Line

			0

Location

Rig up

Drilling and Remarks:

10 + A

RECORD

Cased _____ in., _____ ft.

Sand KC 2410

Gas _____

Oil _____

Total Depth 2460

PRODUCTION

1st 24 hrs. Nat. _____

1st 24 hrs. after shot _____

Gas _____ Cu. Ft.

Dry Hole _____

Abandoned _____

Date

ORVAL MANNSCHRECK

7-17-35 192

Scout