FORM 51 5M BRIX


KANSAS

McPherson

Section 1 Township 18 Range 4W

Well No. #2 Nelson

Company Texas

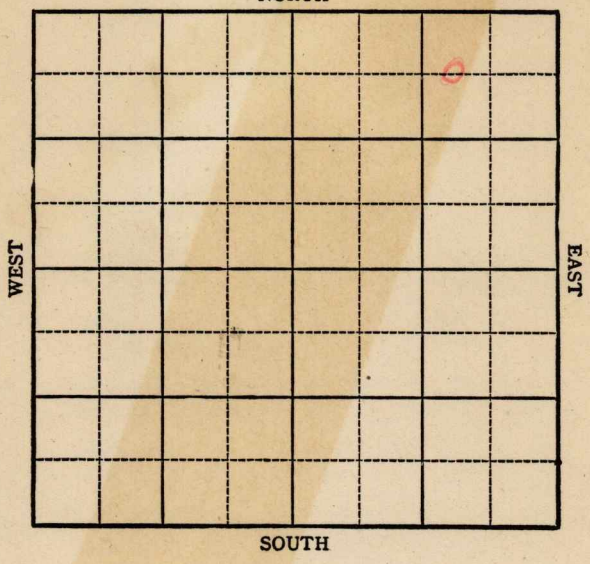

FORM 252-A
5M 3-44 PETROL

KANSAS

McPherson County

Sec. 1 Twp. 18 R. 4W

Well No. #2 Nelson Farm

Texas Company


Lindsborg

660 Ft. from N. Line

Ft. from S. Line

990 Ft. from E. Line

Ft. from W. Line

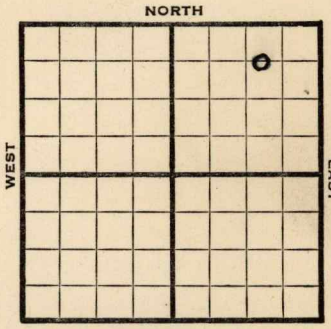

C W L NE NE Elev. 1355

1944	REPORT
8/9	Loc.
8/16	"
8/23	RUR
8/30	13" @ 196
	8" @ 422
	1070 WOC
9/8	Drlg. 2440
9/13	Drlg. 3416
9/20	Viola 3445
	Simp 3504
	TD 3555

ABANDONED

FORM 26 200 BKS. 2-44 PETROL

Pool Name Lindsborg

KANSAS

Map No. Sec. 1 Twp. 18 R. 4W


Well No. 2 Nelson

Texas Company

FIRST REPORT Contractor

C W L NE NE

SECTION PLAT

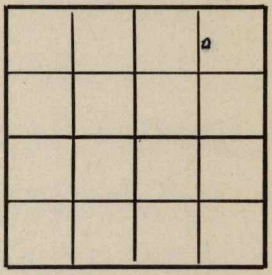

660 Ft. from N. Line

Ft. from S. Line

990 Ft. from E. Line

Ft. from W. Line

McPherson County

Location x

Rig up

Drilling and Remarks:

RECORD

Cased in., ft.

Sand

Gas

Oil

Total Depth

PRODUCTION

1st 24 hrs. Nat.

1st 24 hrs. after shot

Gas Cu. Ft.

Dry Hole

Abandoned

Date

AUG 9 1944 19 S. J. LEWIS Scout

FORM 26 200 BKS 1-44 PETROL

KANSAS

Pool Name Lindsborg Pool

Map No. 44 Sec. 1 Twp. 18 R. 4W


Well No. 2 Nelson

Texas Company

ABANDONED Contractor

C W L NE NE

SECTION PLAT

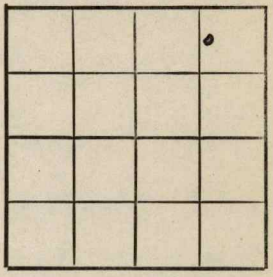

660 Ft. from N. Line

Ft. from S. Line

990 Ft. from E. Line

Ft. from W. Line

McPherson

Location

Rig up

Drilling and Remarks:

Viola 3445

Simp 3504

RECORD

Cased in., ft.

Sand

Gas

Oil

Total Depth 3555

PRODUCTION

1st 24 hrs. Nat.

1st 24 hrs. after shot

Gas Cu. Ft.

Dry Hole

Abandoned

Date

SEP 20 1944 19

S. J. LEWIS Scout