


Section 2 Township 18 Range 4 W

Well No. # 1 Olson

Company K & E & Nate Appleman

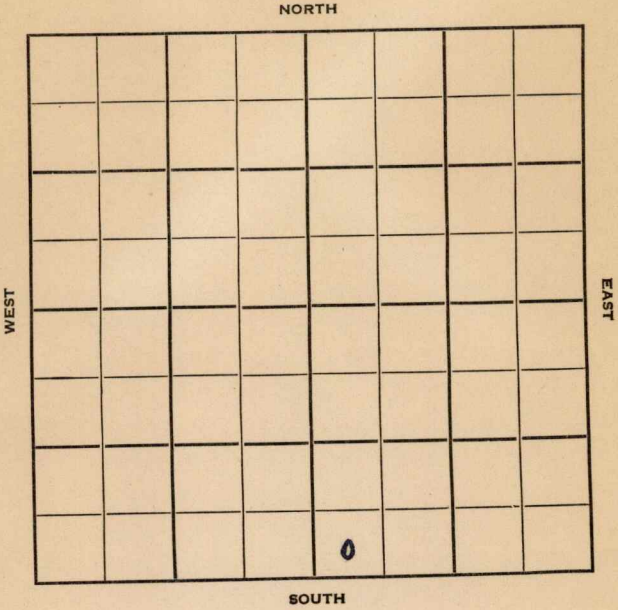

Sec. 2 Twp. 18 R. LWWell No. #1 Olson FarmK&E & Nate Appleman CompanyK&E ContractorWildcat

Ft. from N. Line

330

Ft. from S. Line


Ft. from E. Line

330

Ft. from W. Line

SW SW SE

British American-DHM

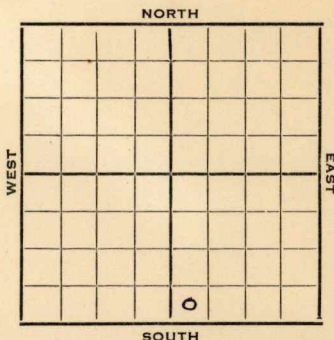

1952

Elev. 1421'

REPORT

5/21

MI

5/28

13" @ 155'

Drlg. 2074'

6/11

Spud 5-21-52

D&A TD 3670

13" @ 155 Lans. 2441

Miss 3070 Kh 3297

Misener 3532

DST 3532-40 opn 1 hr.

Rec. 23' wtry mud

Simp dol. 3649

Viola 3606

Simp sd 3659

TD 3670 D&A


ABANDONED

County **McPherson** State **Kansas**
 Sec. **2** (Blk.) **18** (Sur.) **4W** Map No.

Operator **K&E & Nate Appleman**

Well No. **1** Farm **Olson**

Elev. Location **SW SW SE**

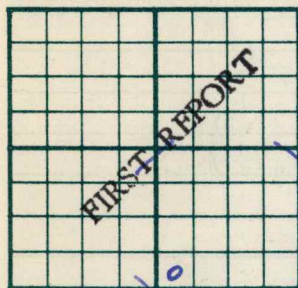

330 Ft. From **S** Line **SE**

330 Ft. From **W** Line Quarter

1st. Report **MAY 21 1962**

Completion

Remarks **British American-IHM**

K & E - Contr.

Spudding Date

Drlg. Data **Wildcat**

MI

J. G. McGEHEE

County McPherson State Kansas
 Sec. 2 (Blk.) 18 (Sur.) 4W Map No.

Operator K & E Drlg. & Nate Appleman

Well No. 1 Farm Olson

Elev. 1421 Location SW SW SE



330 Ft. From S Line SE

330 Ft. From W Line Quarter

1st. Report

JUN 11 1952

Completion

Remarks

Wildcat

K & E Drlg. - Contr.

Spudding Date

5-21-52

Drlg. Data

D & A

TD 3670

13" @ 155 Lans. 2441 Miss. 3070

Kh. 3297 Misener 3532 DST 3532-40

open 1 hr. Rec. 23' wtry mud Simp.

dol. 3649 Viola 3606 Simp. sd. 3659

TD 3670

D & A

J. G. McGEHEE