

KANSAS

Form 51—5M—7-39—Palace


Barton

Section 6 Township 20 Range 11-W

Well No. #1 Hull

Company Crown Petroleum

NORTH Ellinwood Pool

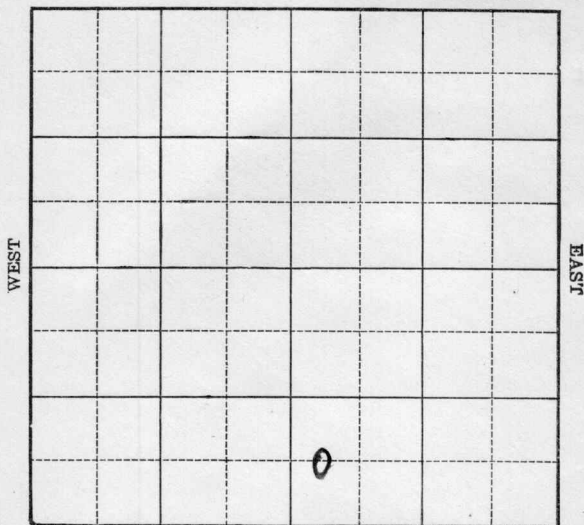

SOUTH

Sec. 6 Twp. 20 R. 11-WWell No. #1 Hull Farm

Crown Petr.

Company

(Ellinwood)

Ft. from N. Line

660


Ft. from S. Line

Ft. from E. Line

330

Ft. from W. Line

Elev. 1784

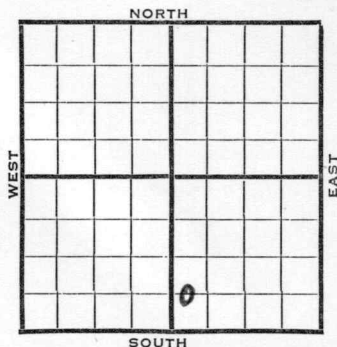

1940

REPORT

3/27

Pits.

4/4

Rigging up rotary.

4/12

10" - 305' Anhy 540'

Drlg. 1501'

4/18

Drlg. 2950'

4/24

Arb. 3381'

T.D. 3387'

No shows.

ABANDONED

Map No. 46 Sec. 6 Twp. 20 R. 11WWell No. 1 HullCrown Petroleum

Company

FIRST REPORT

Contractor

C W L SW SE**SECTION PLAT**

		0	

Ft. from N. Line

660

Ft. from S. Line

Ft. from E. Line

330

Ft. from W. Line

ELLINWOOD POOL

Location _____

RECORD

Cased _____ in., _____ ft.

Sand _____

Gas _____

Oil _____

Total Depth _____

Rig up _____

Drilling and Remarks:

Pits**PRODUCTION**

1st 24 hrs. Nat. _____

1st 24 hrs. after shot _____

Gas _____ Cu. Ft.

Dry Hole _____

Abandoned _____

Date

MAR 27 1940S. J. LEWIS

Scout

Map No. _____ Sec. 6 Twp. 20 R. 11WWell No. 1 HullCrown Petroleum Company

Contractor _____

ABANDONED
C W L SW SE

SECTION PLAT

		0	

_____ Ft. from N. Line

660 Ft. from S. Line

_____ Ft. from E. Line

330 Ft. from W. Line

ELLINWOOD POOL

Location _____

Rig up _____

Drilling and Remarks:

*Ar 83381**Noshows*

RECORD

Cased _____ in., _____ ft.

Sand _____

Gas _____

Oil _____

Total Depth 3247

PRODUCTION

1st 24 hrs. Nat. _____

1st 24 hrs. after shot _____

Gas _____ Cu. Ft.

Dry Hole _____

Abandoned _____

Date

APR 24 1940 19

S. J. LEWIS

Scout

Please check Top Arb. & total
depth and advise.

Paul.

860
850

850

RECORD

Location

Kit up

Drilling and Remarks

Misc. Small Maps
Cards
Tracing
France Map
Scarborough Map
Moody Map
Geological Dept.
Moody Flat Book

Date

Map No. 46 Sec. 6 Twp. 20 R. 11WWell No. 1 Hull

Crown Petroleum

Company

CORRECTION

Contractor

C W L SW SE

 Ft. from N. Line660 Ft. from S. Line Ft. from E. Line330 Ft. from W. Line

ELLINWOOD POOL

SECTION PLAT

		0	

Location Rig up

Drilling and Remarks:

Arb. 3381

No shows

RECORD

Cased in., ft.Sand Gas Oil Total Depth 3387

PRODUCTION

1st 24 hrs. Nat. 1st 24 hrs. after shot Gas Cu. Ft.Dry Hole Abandoned

Date

MAY 1 1940 19

S. J. LEWIS

Scout