


Section 6 Township 20 Range 11W

Well No. #1 Knop

Company Pickrell Drlg.

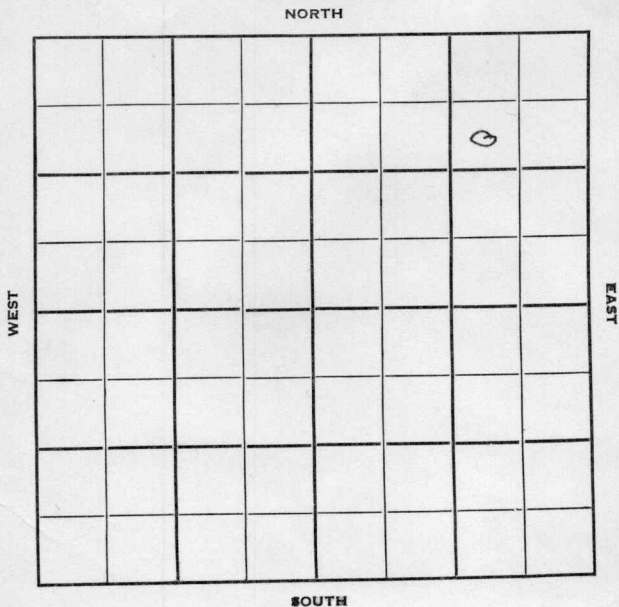

Sec. 6 Twp. 20 R. 11W

Well No. #1 Knop Farm _____

Pickrell Drlg. Company _____

" Contractor Chase-Silica Pool


1090 Ft. from N. Line

_____ Ft. from S. Line

1090 Ft. from E. Line

_____ Ft. from W. Line

SW NE NE

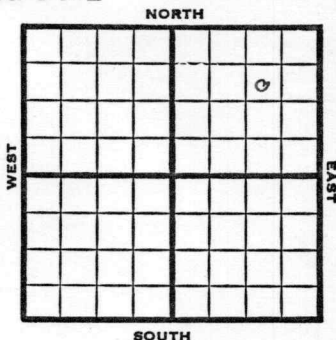

1952

Elev. 1783' REPORT

10/15

Spud 10-9-52
10" @ 342'
Anhy 550'
Drlg. 2425'

10/22

Heeb 2930' Br li 3052' Lans. 3073'
DST 3054-98, 1 hr, 400' gas, 37' 0
& GCM 550#
DST 3122-46, 1 hr, 140' gas & OCSW
DST 3153-60, 1 hr, 7' M
Arb. 3334'
DST 3334-39' RTD 1 hr, 60' 0 & GCM
1160# 7" @ 3334'

10/29

CO 3339 TD 35 galoph 500th
S/2 BOPH

11/5

NR

11/12

"

11/19

Spud 10-9-52 Oil well TD 3339'
10" @ 342' Anhy 550' Heeb 2930'
Br. lime 3052' Lans. 3073'
DST 3054-98 open 1 hr. rec 400' gas
37' 0 & GCM 550#
DST 3222-46 open 1 hr. rec 140' G &
OCSW
DST 3153-60 open 1 hr. rec 7' mud
Arb. 3334'

OVER

1952

11/19

(Information continued)

DST 3334-39 open 1 hr. rec 60' 0 &
GCM 1160# 7" @ 3334 CO to 3339
35 GOPH 500 A S/2 BOPH
Comp. 25 BOPD

COMPLETED

County Barton State Kansas

Sec. 6 (Blk. 20 (Sur. 11W (Twp. 11W Map No.

Operator Pickrell Drlg.

Well No. 1 Farm Knop

Elev. 1783 Location SW NE NE

1090 Ft. From N Line NE

1090 Ft. From E Line Quarter

1st. Report

Completion NOV 19 1952

Remarks Chase-Silica Pool

Pickrell Drlg. - Contr.

Spudding Date 10-9-52

COMPLETE

Drlg. Data Oil well TD 3339

10" @ 342 Anhy 550 Heeb. 2930

Br. lime 3052 Lans. 3073 DST 3054-98

open 1 hr. Rec. 400' gas 37' o & gcm

550# DST 3122-46 open 1 hr. Rec.

140' g & ocs w DST 3153-60 open 1 hr.

Rec. 7' mud Arb. 3334 DST 3334-39

open 1 hr. Rec. 60' o & gcm 1160#

7" @ 3334 CO to 3339 35-goph 500 A

S/ 2 boph Comp. 25 bond