


Section 12 Township 18 Range 4W

Well No. 1 Priddy

Company Anschutz Drlg.

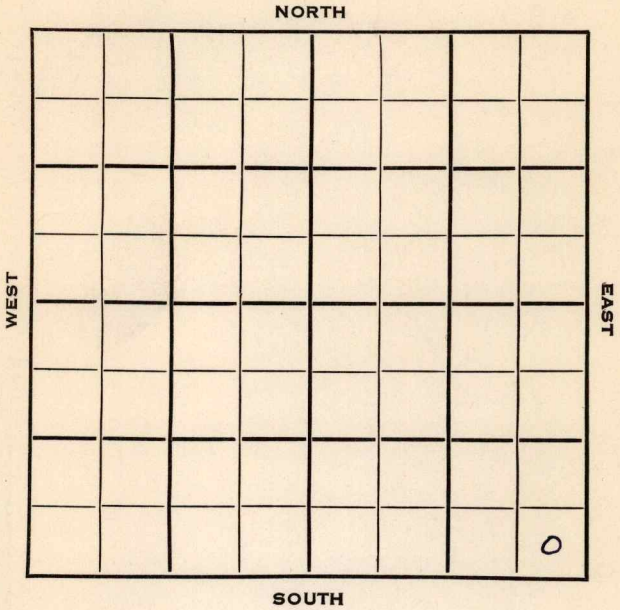

Sec. 12 Twp. 18 R. 4 W

Well No. # 1 Priddy Farm _____

Anschutz Drlg. Company _____

Anschutz
Wildcat Contractor _____


_____ Ft. from N. Line

330 Ft. from S. Line

330 Ft. from E. Line

_____ Ft. from W. Line

SE SE SE

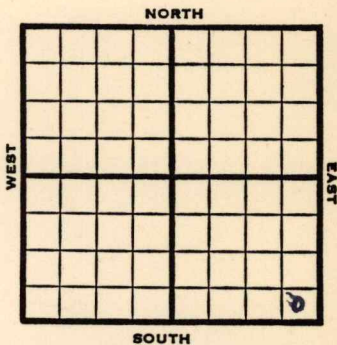

1953 **Elev. 1408'** REPORT

2/11 Spud 2-5-53
8" @ 187
Anhy 460'

2/19 Drlg. 2030'
Heeb 2111 Br li 2338 Miss 2979
KH 3221 Maq Dol 3441
DST 3443-52, 1 hr, 20' M 670# 20"
V 3508

Drlg. 3519

2/25 Spud 2-5-53 D & A TD 3662
8" @ 187 **Anhy 460 Heeb 2111**
KC 2338 Miss 2979 Kh. 3221
Maq. dol. 3441'

DST 3443-52 open 1 hr. rec 20' mud **EX**
670# **Viola 3508 Simp 3553**
Arb. 3625'

TD 3662 D & A

ABANDONED

