
FORM 51 25M 3-49 PETROL

Barton KANSAS

Section 6 Township 20 Range 11 W

Well No. # 1 Knopf

Company B & R Drlg. et al

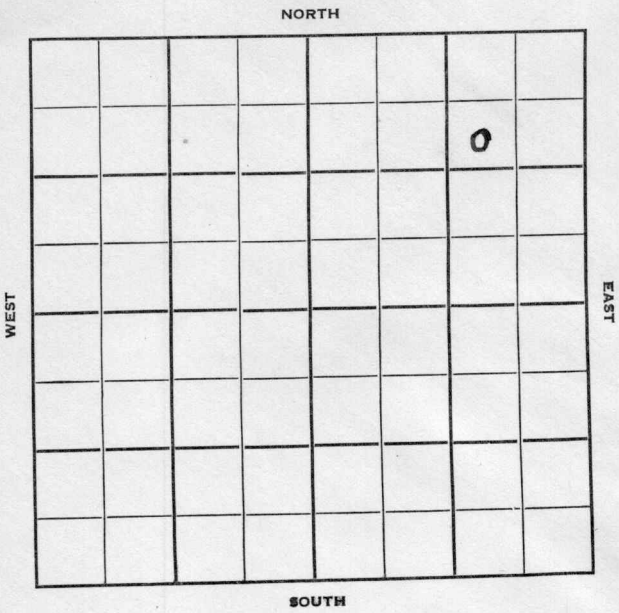

FORM 252-B
10M 8-51 TPCO. Barton

KANSAS

Sec. 6 Twp. 20 R. 11W

Well No. #1 Knopf Farm

B & R Drlg. et al Company

Contractor


990 Ft. from N. Line

Ft. from S. Line

990 Ft. from E. Line

Ft. from W. Line

SW NE NE

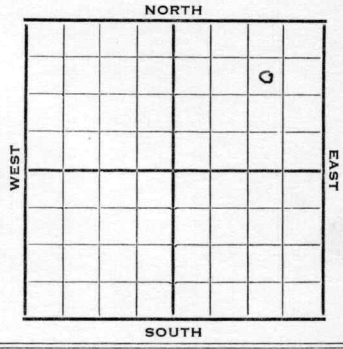

1952 Elev. 1782' REPORT

4/30 Spud 4-26-52
10" @ 174'
Drlg. 1165'

5/7 Topek 2704' Heeb 2931'
Br li 3051' Lans. 3074'
DST 3076-97'

5/14 DST 3082-93 1 hr. 180' SW 60' GCM
1240# DST 3174-95 1 hr. 1620'
SW 1220# RTD 3335 7" @ 3335

5/21 Pipe collapsed

5/28 RUR fishing @ 1700'

6/11 Spud 4-26-52 D&A TD 3335'
10" @ 174' Top. 2704 Heeb. 2931
Br Li 3051 Lans. 3074
DST 3076-97 DST 3082-93 open 1 hr.
rec. 180' sw 60' gcm DST 3174-95
open 1 hr. rec. 1620' sw TD 3335
7" @ 3335' pipe caved D&A

ABANDONED

FORM 275 FOR SALE BY KANSAS BLUE PRINT CO.


County Barton State Kansas

Sec. 6 (Blk. Twp.) 20 (Sur. Rge.) 11W Map No.

Operator B & R Drlg. etal.

Well No. 1 Farm Knopf

Elev. Location SW NE NE

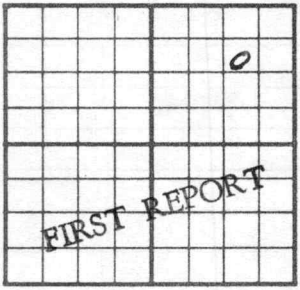

990 Ft. From N Line NE

990 Ft. From E Line Quarter

1st. Report APR 30 1952

Completion

Remarks

Spudding Date 4-26-52

Drlg. Data

10" @ 174 Drlg. 1165

J. G. McGEHEE

FORM 275 FOR SALE BY KANSAS BLUE PRINT CO


County Barton State Kansas

Sec. 6 (Blk. Twp.) 20 (Sur. Rge.) 11W Map No.

Operator B & R Drlg. etal.

Well No. 1 Farm Knopf

Elev. 1782 Location SW NE NE

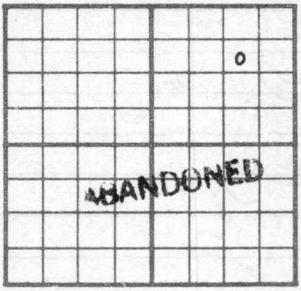

990 Ft. From N Line NE

990 Ft. From E Line Quarter

1st. Report

Completion JUN 11 1952

Remarks

Spudding Date 4-26-52

Drlg. Data D & A TD 3335

10" @ 174 Top. 2704 Heeb. 2931

Br. lime 3051 Lans. 3074 DST 3076-97

DST 3082-93 open 1 hr. Rec. 180' sw

60' gcm DST 3174-95 open 1 hr.

Rec. 1620' sw TD 3335 7" @ 3335

pipe caved

D & A

J. G. McGEHEE