


Barton

KANSAS

Section 7 Township 20 Range 11-W


Well No. #1 Koch

Company Crown Petr. & C. E. Ash

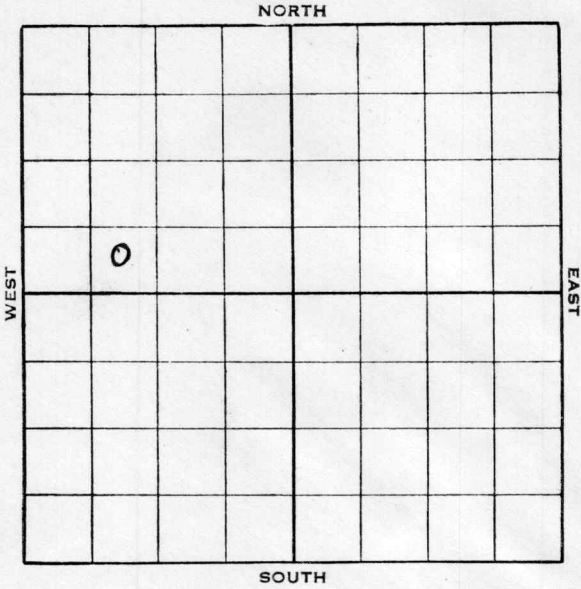

Sec. 7 Twp. 20 R. 11-WWell No. #1 Kock FarmCrown Petr. & C. E. Ash Company Ft. from N. Line330 Ft. from S. Line Ft. from E. Line990 Ft. from W. Line

Elev. 1788

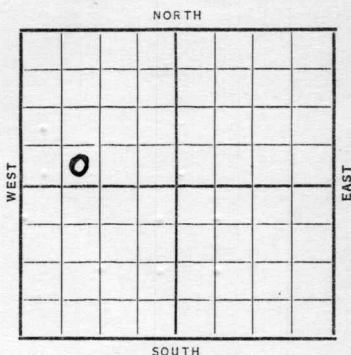

Date	REPORT
1938	
7/6	B.C.R.
7/15	C. R.
7/22	"
7/29	"
8/5	"
8/12	"
8/19	"
8/26	"
9/2	"
9/9	"
9/16	"
9/23	15" - 82'.
	Dlg. 105'.
9/30	Anhy 545'. Dlg. 1005'.
10/7	12" - 562'. Dlg. 1825'.
10/14	10" - 1865'. Dlg. 2095'.
10/21	8" - 2167'. Dlg. 2515'.
10/28	Topeka 2700'. Lans. 3090'.
	S. O. 3090-95'. T.D. 3105'.
	U. R. 8".

OVER

1938

11/2 5" - 3357'.

Arb. 3345'.

T. D. 3394'.

H. F. W.

ABANDONED

Barton KANSAS

Map No. 46 Sec. 7 Twp. 20 R. 11WWell No. 1 KookCrown Petroleum & C. E. Ash
Company

Contractor

FIRST REPORT

SE SW NW

____ Ft. from N. Line

330 Ft. from S. Line

____ Ft. from E. Line

990 Ft. from W. Line

SECTION PLAT

Location _____

Rig up _____

Drilling and Remarks:

BCR

RECORD

Cased _____ in., _____ ft.

Sand _____

Gas _____

Oil _____

Total Depth _____

PRODUCTION

1st 24 hrs. Nat. _____

1st 24 hrs. after shot _____

Gas _____ Cu. Ft.

Dry Hole _____

Abandoned _____

Date

JUL 6 - 1938 19

H. D. Hatfield Scout

Barton

KANSAS

Map No. 46 Sec. 7 Twp. 20 R. 11WWell No. 1 KockCrown Petroleum & C. E. Ash
Company

Contractor

ABANDONED

SE SW NW

 Ft. from N. Line330 Ft. from S. Line Ft. from E. Line990 Ft. from W. Line

SECTION PLAT

0			

Location Rig up

Drilling and Remarks:

HFW

DVA

RECORD

Cased 5 in., 3357 ft.Sand Arb 3345Gas Oil Total Depth 3394

PRODUCTION

1st 24 hrs. Nat. 1st 24 hrs. after shot Gas Cu. Ft.Dry Hole Abandoned

Date

NOV 2 - 1938

19

H. D. Hatfield Scout