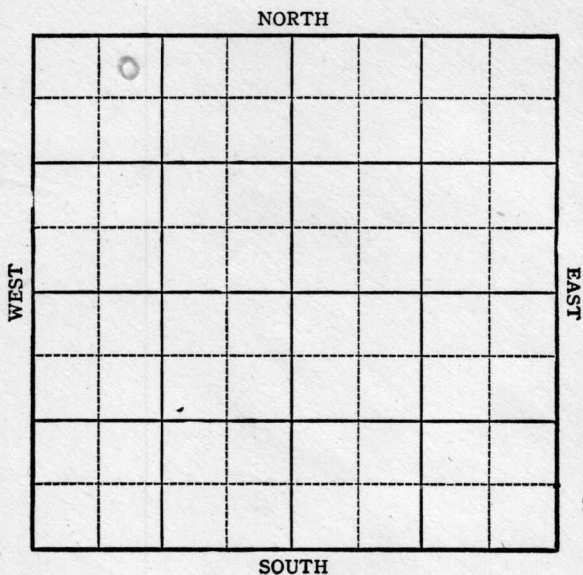


KANSAS

Barton

Section 7 Township 20 Range 11WWell No. #3 Koch "A"Company C E Ash

Barton

Sec. 7 **KANSAS** Twp. 20 R. 11W

Well No. #3 Koch "A" Farm

C E Ash Company

Ellinwood


330 Ft. from N. Line

 Ft. from S. Line

 Ft. from E. Line

990 Ft. from W. Line

Elev. 1796

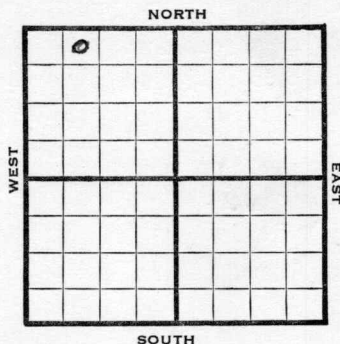

1944

REPORT

7/26 Cellar
8/2 "
8/9 "
8/16 Surface hole
8/23 8" @ 323
 Anhy 540
 Drlg 2720
8/30 Lans 3092
 Cong. 3332
 Arb 3344
 TD 3376

ABANDONED

Pool Name Ellinwood

KANSAS

Map No. 46 Sec. 7 Twp. 20 R. 11WWell No. 3 Koch "A"C. E. Ash CompanyFIRST REPORT Contractor

NE NW NW

SECTION PLAT

330 Ft. from N. Line Ft. from S. Line Ft. from E. Line990 Ft. from W. Line

0			

Barton County

Location Rig up

Drilling and Remarks:

Cellar

RECORD

Cased in., ft.Sand Gas Oil Total Depth

PRODUCTION

1st 24 hrs. Nat. 1st 24 hrs. after shot Gas Cu. Ft.Dry Hole Abandoned

Date

JUL 26 1944

19


S. J. LEWIS

Scout

Pool Name Ellinwood PoolMap No. 46 Sec. 7 Twp. 20 R. 11WWell No. 3 Koch "A"C. E. Ash CompanyABANDONED Contractor

NE NW NW

SECTION PLAT

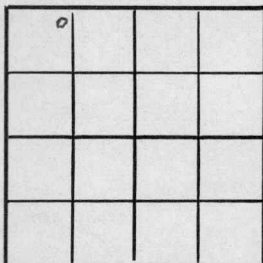330 Ft. from N. Line Ft. from S. Line Ft. from E. Line990 Ft. from W. Line

Barton

Location Rig up

Drilling and Remarks:

Lease 3092Coalg 3332Coalg 3344

RECORD

Cased in., ft.Sand Gas Oil Total Depth 9376

PRODUCTION

1st 24 hrs. Nat. 1st 24 hrs. after shot Gas Cu. Ft.Dry Hole Abandoned

Date

AUG 30 1944 19 S. J. LEWIS Scout