

KANSAS


FORM 51 5M 10-41 PETROL

McPharson

Section 22 Township 18 Range 4-W

Well No. #1 Larson

Company Auto Ordance

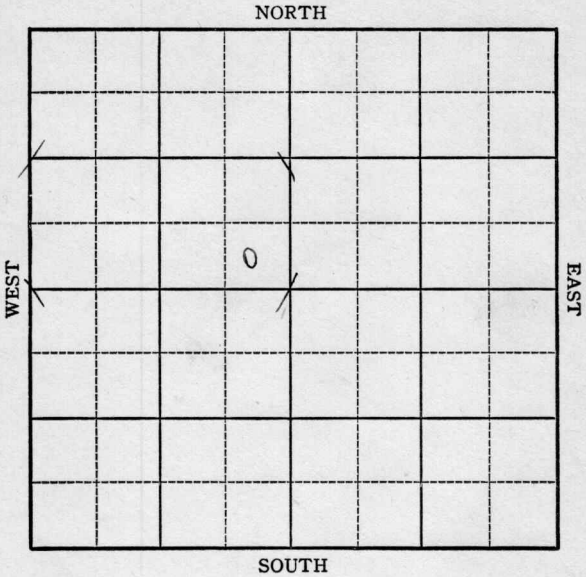

KANSAS

McPherson

Sec. 22 Twp. 18 R. 4-W

Well No. #1 Larson Farm

Auto Ordnance Company

Wildcat

Ft. from N. Line


330

Ft. from S. Line

330

Ft. from E. Line

Ft. from W. Line

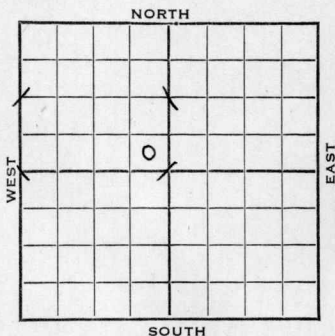

Elev. 1507

1943

REPORT

2/25

Location.

3/3

16" Casing set 196 WOC.

3/10

10" Casing set 588'

Drlg. 1860'

3/17

Lans 2497

Miss 3144

Drlg. 3220'

3/24

Arb. 3776

B. Miss. 3378

Viola 3609

Simp. 3699

T.D. 3815'

No shows.

ABANDONED

KAN 844
Map No. _____ Sec. 22 Twp. 18 R. 4WWell No. 1 Larson

Auto Ordnance

Company

FIRST REPORT

Contractor


SE NW

SECTION PLAT

_____ Ft. from N. Line

330 Ft. from S. Line330 Ft. from E. Line

_____ Ft. from W. Line

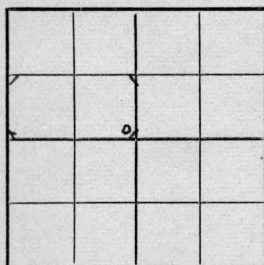

WILDCAT

Location XXX

Rig up _____

Drilling and Remarks:

RECORD

Cased _____ in., _____ ft.

Sand _____

Gas _____

Oil _____

Total Depth _____

PRODUCTION

1st 24 hrs. Nat. _____

1st 24 hrs. after shot _____

Gas _____ Cu. Ft.

Dry Hole _____

Abandoned _____

Date

FEB 24 1943 19S. J. LEWIS Scout

McPherson

KANSAS

Map No. 44 Sec. 22 Twp. 18 R. 4 WWell No. 1 Larson

Auto Ordnance


Company

ABANDONED

Contractor

SE NW

SECTION PLAT

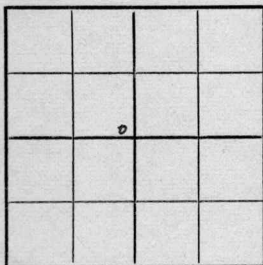

_____ Ft. from N. Line

330 Ft. from S. Line330 Ft. from E. Line

_____ Ft. from W. Line

WILDCAT

Location _____

Rig up _____

Drilling and Remarks:

*Cee 3276.**B Miss 3378**Viola 3609**Smy 3659**No show*

RECORD

Cased _____ in., _____ ft.

Sand _____

Gas _____

Oil _____

Total Depth 3715.

PRODUCTION

1st 24 hrs. Nat. _____

1st 24 hrs. after shot _____

Gas _____ Cu. Ft.

Dry Hole _____

Abandoned _____

Date

MAR 24 1943 19S. J. LEWIS Scout