


Section 29 Township 14 Range 13-W

Well No. 1 Rogg

Company Sinclair-Prairie

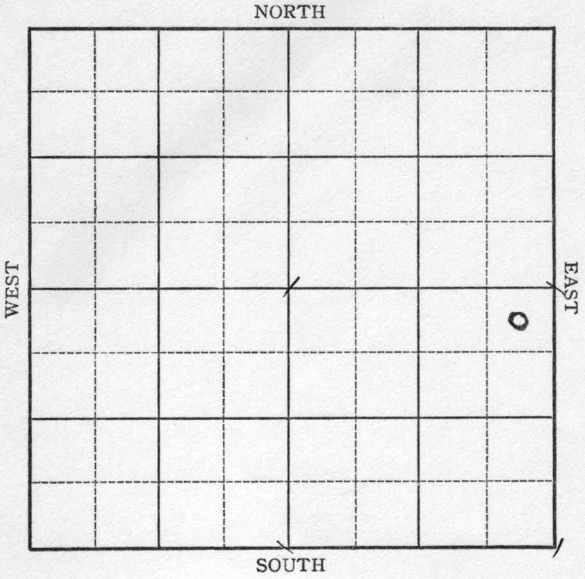

1938

3/2 8" @ 2902'.

K.C. 2878'.

T.D. 2916 $\frac{1}{2}$ '.

P.B. 2912 $\frac{1}{2}$ '.

8000 acid.

Potential 760 oil.

No water.

COMPLETED

Russell

KANSAS

Map No. _____ Sec. 29 Twp. 14 R. 13W

Well No. 1 Rogg

Sinclair Prairie Company

Contractor

FIRST REPORT

SECTION PLAT

NE SE


330 Ft. from N. Line

_____ Ft. from S. Line

330 Ft. from E. Line

_____ Ft. from W. Line

Special

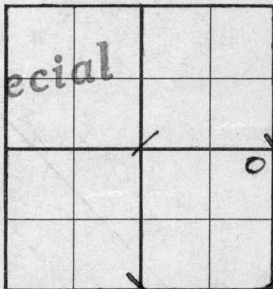

Location _____

Rig up _____

Drilling and Remarks:

RUR

RECORD

Cased _____ in. _____ ft.

Sand _____

Gas _____

Oil _____

Total Depth _____

PRODUCTION

1st 24 hrs. Nat. _____

1st 24 hrs. after shot _____

Gas _____ Cu. Ft.

Dry Hole _____

Abandoned _____

Date

JAN 26 1938

19

H. D. Hatfield Scout

Russell

KANSAS

Map No. _____ Sec. 29 Twp. 14 R. 13W

Well No. 1 Rogg

Sinclair Prairie Company

Contractor _____

COMPLETED

NE SE

330 Ft. from N. Line

_____ Ft. from S. Line

330 Ft. from E. Line

_____ Ft. from W. Line

SECTION PLAT

			0

Location _____

Rig up _____

Drilling and Remarks:

P.B. 2912 1/2
8000 acid
POT 760 oil
NO WTR

RECORD

Cased 8 in., 2902 ft.

Sand KC 2878

Gas _____

Oil _____

Total Depth 2916 1/2

PRODUCTION

1st 24 hrs. Nat. _____

1st 24 hrs. after shot _____

Gas _____ Cu. Ft.

Dry Hole _____

Abandoned _____

Date

MAR 2 - 1938 19

H. D. Hatfield

Scout