


Russell

Section 29 Township 14 Range 13-W

Well No. 3 Opdycke

Company Skelly Oil

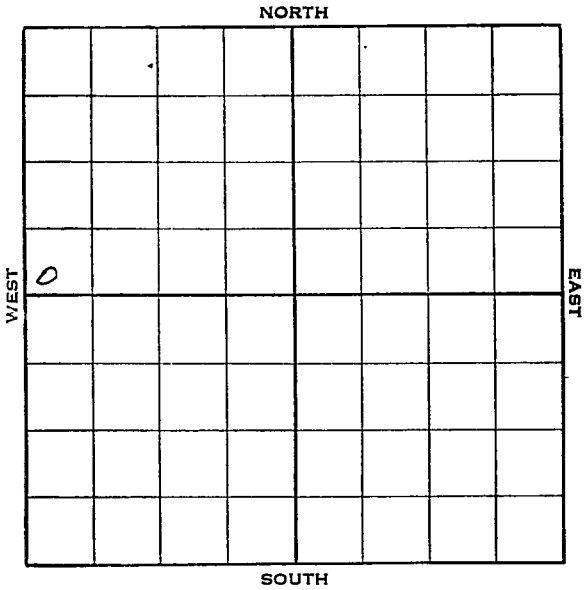

KANSAS


Russell

Sec. 29 Twp. 14 R. 13-WWell No. #3 Opdycke FarmSkelly Oil Company

Ft. from N. Line

330 Ft. from S. Line

Ft. from E. Line

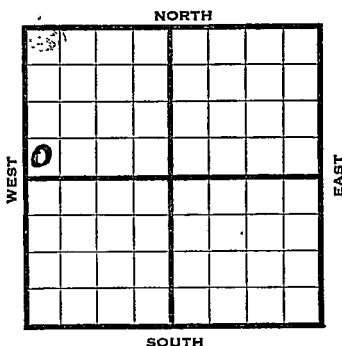330 Ft. from W. LineElev. 1741'

1938	REPORT
6/15	B.R.R.
6/24	RUCT.
7/1	20" - 30      15" - 172'
	Drlg. 185'
7/8	Drlg. 410'.
7/15	Anhy 667'. 10" - 680'.
	Dlg. 1355'.
7/22	Dlg. 2185'.
7/29	S. G. 2320'. 8" - 2375'.
	S. O. 2480-85'. Fsg. 2680'.
8/5	Lans. 2873'. 7" - 2901'.
	Sat. Lime 2911-19' T.D.
	105' oil in 5 hrs.
	8000 acid.
8/12	Pumped 1 oil & 10 wtr. per hr.
	5 hrs. Will deepen.
8/19	Dlg. 3133'.
8/26	Granite wash 3141'.
	5" - 3141'. T.D. 3164'. C. O.
	No. shows.
	OVER

1938

9/2 T. D. 3243' in Granite.  
P. B. 3155'. 800' oil in hole.  
5" - 3153'. WOC.

9/9 C. O. 3243'. P. B. 3180'.  
Shot 30 qts. 3163-80' C. O.  
800' oil.

9/14 5" - 3153'.  
Granite wash 3141'.  
T. D. 3243'.  
P. B. 3180'.  
Shot 30 qts. 3163-80'.  
1000' oil.  
Pump 91 bbls. 4 hrs. & 72 bbls.  
4 hours.  
Potential 429 bbls.

COMPLETED

Map No. 72 Sec. 29 Twp. 14 R. 13WWell No. 3 OpdyckeSkelly Oil

Company

Contractor

## FIRST REPORT

SW NW

\_\_\_\_\_ Ft. from N. Line

330 Ft. from S. Line

\_\_\_\_\_ Ft. from E. Line

330 Ft. from W. Line

## SECTION PLAT

0			

Location \_\_\_\_\_

Rig up \_\_\_\_\_

Drilling and Remarks:

BRR

## RECORD

Cased \_\_\_\_\_ in., \_\_\_\_\_ ft.

Sand \_\_\_\_\_

Gas \_\_\_\_\_

Oil \_\_\_\_\_

Total Depth: \_\_\_\_\_

## PRODUCTION

1st 24 hrs. Nat. \_\_\_\_\_

1st 24 hrs. after shot \_\_\_\_\_

Gas \_\_\_\_\_ Cu. Ft.

Dry Hole \_\_\_\_\_

Abandoned \_\_\_\_\_

Date

JUN 15 1938

19

H. D. Hatfield Scout

