

Stanton


KANSAS

SECTION 5 TOWNSHIP 28S RANGE 40W

WELL NO. #1 Plummer "D"

COMPANY Graham-Michaelis

NORTH C NE/4

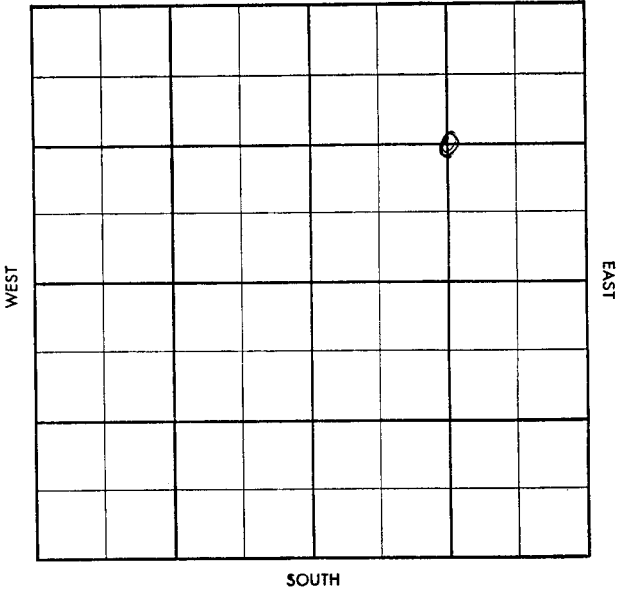

Top Pool ☒
 Bottom Pool ☒

S-513-B

County Stanton Elev.
 Sec. 5 Twp. 28 Rge. 40W
 Company Graham-Michaelis
 Farm Name Plummer "D" No. 1

TOPS	DEPTH	LOG	DATUM
Anh.			
TP.			
H.			
Tr.	<u>Herr.</u>	<u>2207</u>	
Dg.	<u>Kri.</u>	<u>2231</u>	
B.L.			
L.	<u>Winf.</u>	<u>2287</u>	
K.C.			
B.K.C.			
Ce.			
C.			
M.			
M.			
K.			
Mz.			
Mq.			
V.			
S.			
S.			
A.			
R.			
Pf.			
G.			
T.D.	<u>2295</u>		

Loc. in Sec. C NE/4

Geol.
 Contr. Co. tools

Pool Hugoton

FIRST REPORT
AUG 27 '58

Date Comm. 8-21-58
7" @ 2292/600

Co.
Lse.
No.
Sec.
T.
R.

Twp. _____ Pool _____

Co. _____ Facet _____

S-513-B

County Stanton Elev. 3290 OF 3293
 Sec. 5 Twp. 28 Rge. LOW
 Company Graham-Michaelis
 Farm Name Plummer "D" No. 1

TOPS	DEPTH	LOG	DATUM
Anh.			
Tp.			
H.			
Tr.	<u>Herr.</u>	<u>2237</u>	
Dg.	<u>Kri.</u>	<u>2231</u>	
B.L.			
L.	<u>Winf.</u>	<u>2237</u>	
K.C.			
B.K.C.			
Ce.			
C.			
M.			
M.			
K.			
Mz.			
Mq.			
V.			
S.			
S.			
A.			
R.			
Pf.			
G.			
T.D.	<u>2295</u>		

Loc. in Sec. _____

C 15/4

Geol. _____

Contr. _____

Co. tools _____

Pool _____

Hugoton

SEP 17 '58

COMPLETE

Date Comm. 8-21-587" @ 2292/600

SEP 3 '58

CO 2295 ga149 MCF pd DD 2299 1/2 TD ga223 MCF NT 1/2 ga 289 MCF3 ga 787 MCF 1/2 SEP 10 '58 has 6x624/2252-58 ga 590 MCF Kill Well DrovePlug 2298 1/2 ga 7.930 mcf/dhr72-20 15.100 MCF RP 375

SEP 17 '58

open Hole win fieldKrid 2252-58