


Russell

Map No. KANSAS Sec. 30 Twp. 14 R. 13W
Well No. 4-Miller Farm
Russell Oil J.J. HALK company

Ft. from N. Line
330 Ft. from S. Line
Ft. from E. Line
330 Ft. from W. Line

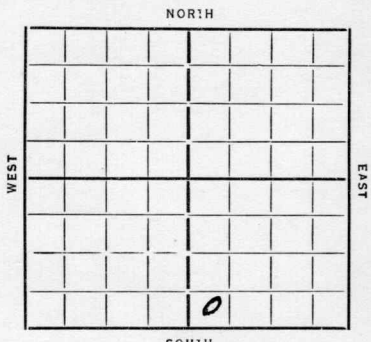

Elev. 1752

Date	REPORT	O. W. D. D
8/21	Rgn	
8/29	Spud.	15" 40
9/6	1635	12" 384
10/3	2976 proof 6 Bbls per hr.	
10/10	3000 acid	
10/17	Oswald 2884	
	T.D. 2976	
	708 Bbls.	

COMPLETED

Date	REPORT	O. W. D. D
1938		
9/28	Old T.D. 2976'.	
	Granite Wash 3155-63'.	
	No shows.	
	P. B. to 2980'.	
	Old potential 708 bbls.	
	No new potential taken.	

FIRST REPORT

and

COMPLETED

Map No. 72 Sec. 30 Twp. 14 R. 13W

Well No. H-Miller
Russell Oil Company

Contractor

FIRST REPORTS

SECTION PLAT

..... Ft. from N. Line
330 Ft. from S. Line
..... Ft. from E. Line
330 Ft. from W. Line

		0	

Location.....

Rig up.....

Drilling and Remarks:

Rig up

RECORD

Cased.....in.,ft.
Sand.....
Gas.....
Oil.....
Total Depth.....

PRODUCTION

1st 24 hrs. Nat.....
1st 24 hrs. after shot.....
Gas.....Cu. Ft.
Dry Hole.....
Abandoned.....

Date 8-21-35 192.....

ORVAL MANN SCHRECK

Scout

KANSAS

Map No. 12 Sec. 30 Twp. 14 R. 13W

Well No. 4-Miller

Russell oil Company

Contractor

COMPLETED

SECTION PLAT

Ft. from N. Line

330 Ft. from S. Line

Ft. from E. Line

330 Ft. from W. Line

Location

Rig up

Drilling and Remarks:

708 lbs

RECORD

Cased in. ft.

Sand Swath 2884

Gas

Oil

Total Depth 2976

PRODUCTION

1st 24 hrs. Nat.

1st 24 hrs. after shot

Gas Cu. Ft.

Dry Hole

Abandoned

Date

10-17-35 192

ORVAL MANNSCHRECK

Scout

Map No. 72 Sec. 30 Twp. 14 R. 13W

Well No. 4 Miller

J. J. Hall Company

FIRST REPORT

Contractor

COMPLETED

SECTION PLAT

SW SE

		0	

_____ Ft. from N. Line

330 Ft. from S. Line

_____ Ft. from E. Line

330 Ft. from W. Line

Location _____

Rig up _____

Drilling and Remarks:

OWDD-OTD 2976

Granite Wash

3155-63

No Shows

PB 2980

Old Poten, 708

No New Poten.
taken

RECORD

Cased _____ in., _____ ft.

Sand _____

Gas _____

Oil _____

Total Depth _____

PRODUCTION

1st 24 hrs. Nat. _____

1st 24 hrs. after shot _____

Gas _____ Cu. Ft.

Dry Hole _____

Abandoned _____

Date

SEP 28 1938₁₉

H. D. Hatfield

Scout