

KANSAS

Form 51-5M-7-39-Palace


Barton

Section 7 Township 20 Range 11-W

Well No. ~~#2~~ ~~#1~~ P. Schartz "A"

Company Crown Petroleum

NORTH Ellinwood Pool

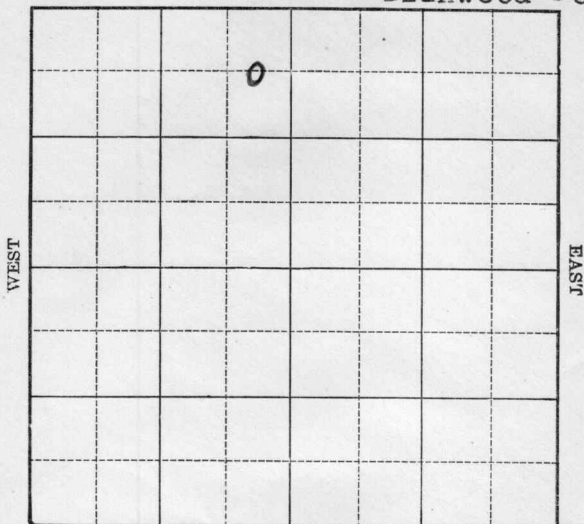

SOUTH

KANSAS

Barton

Sec. 7 Twp. 20 R. 11-WWell No. #2 P. Schartz-"A" Farm

Crown Petr.

Company

(Ellinwood)


660 Ft. from N. Line

Ft. from S. Line

330 Ft. from E. Line

Ft. from W. Line

Elev. 1785

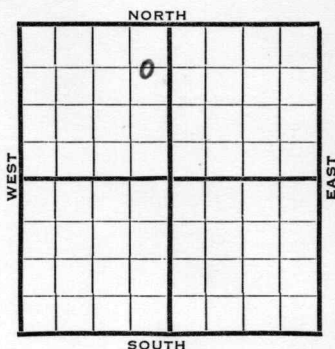

1940	REPORT
4/17	Cellar.
4/25	R.U.
5/2	10" - 302' Anhy 540'
	Drlg. 1585'
5/9	Drlg. 2840'
5/16	Arb. 3332-34' S.O. 5" - 3332'
	RUST.
5/23	T.D. 3352' 2 bbls. oil 12 hrs. 1000 acid. Pump 3 bbls. oil per hour 10 hours.
5/29	2000 acid. Pump 6½ bbls. per hour.
6/5	Arb. 3332'
	5" - 3332'
	T.D. 3352'
	3000 acid.
	Potential 466 bbls., pump.
	COMPLETED

Map No. 46 Sec. 7 Twp. 20 R. 11WWell No. 1 P. SchartzCrown Petroleum

Company

Contractor

FIRST REPORT

SECTION PLAT

	0		

C E L NE NW

660 Ft. from N. Line

Ft. from S. Line

330 Ft. from E. Line

Ft. from W. Line

ELLINWOOD POOL

Location _____

Rig up _____

Drilling and Remarks:

Cellar

RECORD

Cased _____ in., _____ ft.

Sand _____

Gas _____

Oil _____

Total Depth _____

PRODUCTION

1st 24 hrs. Nat. _____

1st 24 hrs. after shot _____

Gas _____ Cu. Ft.

Dry Hole _____

Abandoned _____

Date

APR 17 1940

19

S. J. LEWIS

Scout

Map No. 46 Sec. 7 Twp. 20 R. 11WWell No. 2 P. Schartz "A"Crown Petroleum

Company

CORRECTION

Contractor

C E L NE NW

SECTION PLAT

660 Ft. from N. Line

Ft. from S. Line

330 Ft. from E. Line

Ft. from W. Line

ELLINWOOD POOL

Location _____

RECORD

Cased _____ in., _____ ft.

Sand _____

Gas _____

Oil _____

Total Depth _____

Rig up _____

Drilling and Remarks:

Reported as

#1 P. Schartz

PRODUCTION

1st 24 hrs. Nat. _____

1st 24 hrs. after shot _____

Gas _____ Cu. Ft.

Dry Hole _____

Abandoned _____

Date

MAY 2 1940 19

S. J. LEWIS

Scout

Map No. 46 Sec. 7 Twp. 20 R. 11WWell No. 2 P.Schartz "A"Crown Petroleum CompanyCORRECTION Contractor

SECTION PLAT

C E L NE NW

660 Ft. from N. Line

Ft. from S. Line

330 Ft. from E. Line

Ft. from W. Line

ELLINWOOD POOL

	0		

Location _____

Rig up _____

Drilling and Remarks:

Reported as

#1 P.Schartz

RECORD

Cased _____ in., _____ ft.

Sand _____

Gas _____

Oil _____

Total Depth _____

PRODUCTION

1st 24 hrs. Nat. _____

1st 24 hrs. after shot _____

Gas _____ Cu. Ft.

Dry Hole _____

Abandoned _____

Date

MAY 9 1940 19

S. J. LEWIS Scout

Map No. 46 Sec. 7 Twp. 20 R. 11WWell No. 2 P. Schartz "A"Crown Petroleum

Company

Contractor

COMPLETED

C E L NE NW

660 Ft. from N. Line

Ft. from S. Line

330 Ft. from E. Line

Ft. from W. Line

ELLINWOOD POOL

SECTION PLAT

	0		

Location

Rig up

Drilling and Remarks:

*Ar 3332**5" @ 3332**3000 acid**Pump 466 P.T.*

RECORD

Cased _____ in., _____ ft.

Sand _____

Gas _____

Oil _____

Total Depth 3352

PRODUCTION

1st 24 hrs. Nat. _____

1st 24 hrs. after shot _____

Gas _____ Cu. Ft.

Dry Hole _____

Abandoned _____

Date

JUN 5 1940 19S. J. LEWIS Scout