
FORM 51

Barton KANSAS

Section 26 Township 18 Range 11 W

Well No. # 1 Zink

Company G-M-R Oil

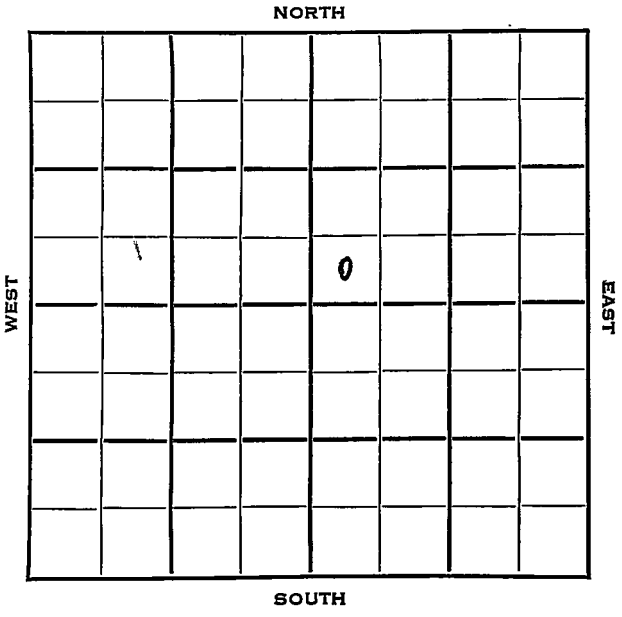

FORM 252-B

Barton

KANSAS

Sec. 26 Twp. 18 R. 11W

Well No. #1 Zink Farm

G-M-R Oil Company

G-M-R Contractor

Ames Pool


Ft. from N. Line

330 Ft. from S. Line

Ft. from E. Line

330 Ft. from W. Line

SW SW NE

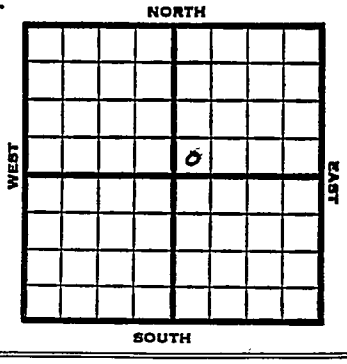

1953	Elev. 1759' REPORT
6/24	Spud 5-17-53 8" @ 158' Anhy 553' Drlg 2824'
7/1	D & A
7/8	Spud 5-17-53 D&A TD 3330 8" @ 158 Anhyd 553, Heeb 2866, Br lime 2983, Lans 3003 DST 3154-87, opn 1 hr., rec. 110' wtry mud, 1220# Arb. 3307 TD 3330 D&A

ABANDONED

FORM 275 FOR SALE BY KANSAS BLUE PRINT CO.


County Barton State Kansas

Sec. 26 (Blk. Twp.) 18 (Sur. Rge.) 11W Map No.

Operator G-M-R Oil

Well No. 1 Farm Zink

Elev. Location SW SW NE

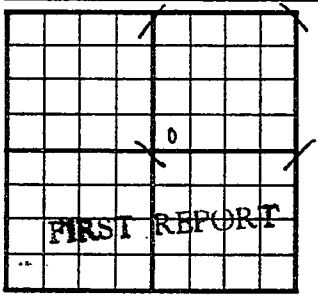

330 Ft. From S Line NE

330 Ft. From W Line Quarter

1st. Report JUN 24 1953

Completion

Remarks

G-M-R - Contr.

Spudding Date 5-17-53

Drlg. Data Ames Pool

8" @ 158 Anhy 553 drlg. 2824

J. G. McGEHEE

FORM 275 FOR SALE BY KANSAS BLUE PRINT CO.


County Barton State Kansas

Sec. 26 (Blk. Twp.) 18 (Sur. Rge.) 11W Map No.

Operator G-M-R Oil

Well No. 1 Farm Zink

Elev. 1759 Location SW SW NE,

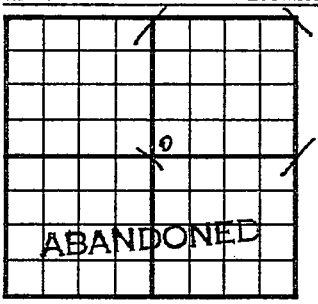

330 Ft. From S Line NE

330 Ft. From W Line Quarter

1st. Report

Completion JUL 8 1953

Remarks Ames Pool

G-M-R - Contr.

Spudding Date 5-17-53

Drlg. Data D & A TD 3330

8" @ 158 Anhy 553 Heeb. 2866

Br. lime 2983 Lans. 3003 DST 3154-87

open 1 hr. Rec. 110' wtry mud 1220#

Arb. 3307 TD 3330

D & A

J. G. McGEHEE