


Map No. _____ Sec. 9 Twp. 20 R. 11-W

Well No. 1 - Gerlof Farm _____

Stanolind Company _____

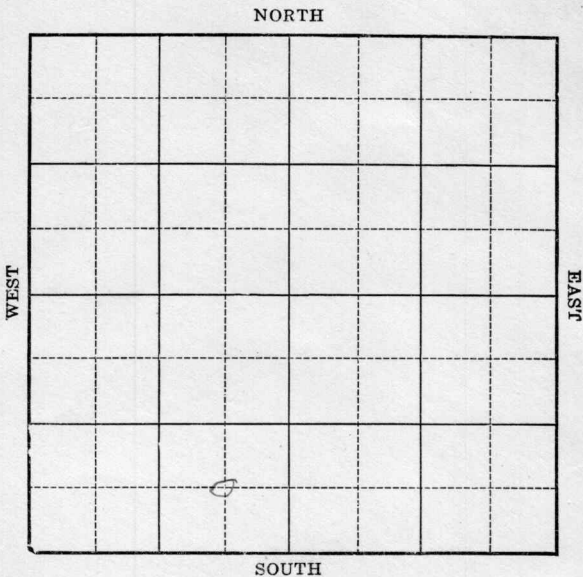

Location _____

Drilling Remarks _____

Rig Up _____

Drilling Remarks _____

RECORD

Cased _____ in. _____ ft.

Sand _____

Gas _____

Oil _____

Total Depth _____

PRODUCTION

1st 24 hrs. Nat. _____

1st 24 hrs. after shot _____

Gas _____ cu. ft.

Dry Hole _____

Abandoned _____

Map No. _____ Sec. 9 Twp. 20 R. 11-W


Well No. 1- Gerlof Farm _____
Stanolind Company _____

_____ Ft. from N. Line

660 Ft. from S. Line

660 Ft. from E. Line

_____ Ft. from W. Line

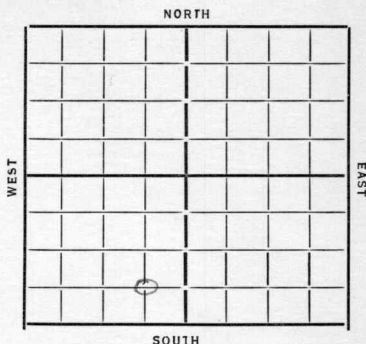

Date 1933

REPORT

6/21 Rotary
6/22 Rig
7/6 13"-20"
7/12 dily 2475
7/19 Top Lansing 3055 dily 3280
7/26 Top Siliceous line 3295-6" 3292
T.H. 3200'
8/2 T.D. 3339' - 2400' fluid
8/9 plugging back to 3320' no test
8/17 pumped 168 bbls 14 hrs treated 800 acid
8/22 pump 100 bbls 24 hrs - 1000 gal acid
116 bbls 24 hrs
8/30 Siliceous 3295-3300
1000 gallon acid
pump 116 bbls

COMPLETED

KANSAS

Map No. 46 Sec. 9 Twp. 20 R. 11N

Well No. 1 Beriof

Manalund Company

..... Contractor

Q.E. S.W.

SECTION PLAT

Ft. from N. Line

660 Ft. from S. Line

660 Ft. from E. Line

Ft. from W. Line

	0		

FIRST REPORTS

Location.....

Rig up.....

Drilling and Remarks:

Rotary

RECORD

Cased.....in.,ft.

Sand.....

Gas.....

Oil.....

Total Depth.....

PRODUCTION

1st 24 hrs. Nat.

1st 24 hrs. after shot.....

Gas.....Cu. Ft.

Dry Hole.....

Abandoned.....

Date _____

6/21/33 192. Coral Mammuchek Scout

Map No. 46 Sec. 9 Twp. 20 R. 11W

Well No. 1-Geology

Stanolind Company

Contractor

SECTION PLAT

Ft. from N. Line

660 Ft. from S. Line

660 Ft. from E. Line

Ft. from W. Line

COMPLETED

	0		

Location

Rig up

Drilling and Remarks:

1000 gallon
acid

pump 116 bbls

RECORD

Cased _____ in., _____ ft.

Sand siliceous 3295

Gas _____

Oil _____

Total Depth 3300

PRODUCTION

1st 24 hrs. Nat. _____

1st 24 hrs. after shot _____

Gas _____ Cu. Ft.

Dry Hole _____

Abandoned _____

Date

8/30/33 192 O. Mannschreck Scout