


Section 25 Township 18 Range 11 W

Well No. # 1 Randenburg

Company Alpine Oil & Royalty

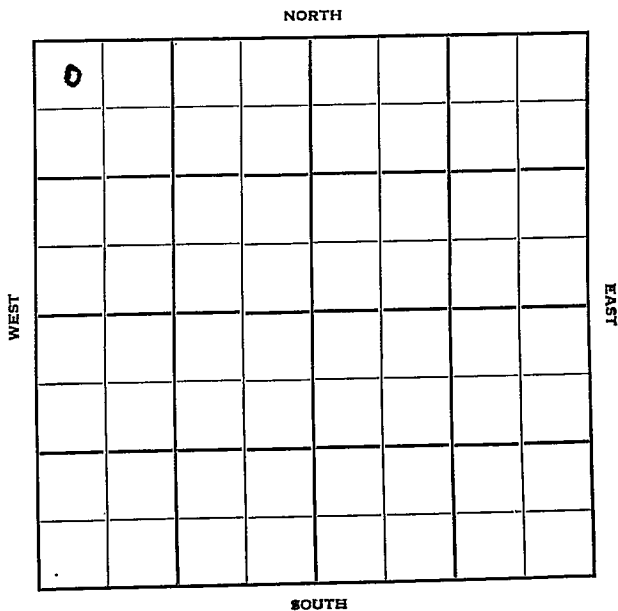

Sec. 25 Twp. 18 R. 11W

Well No. #1 Randenburg Farm

Alpine Oil & Royalty Company

Contractor


330 Ft. from N. Line

Ft. from S. Line

Ft. from E. Line

330 Ft. from W. Line

NW NW NW

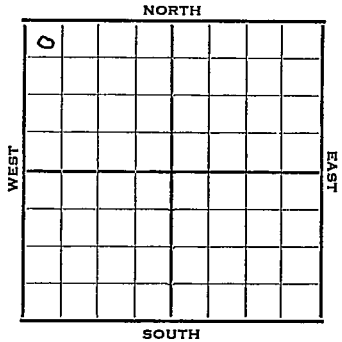

1952 Elev. 1755' REPORT

4/30 Spud 4-28-52
8" @ 200
Drlg. 440'

5/7 Anhy 520' Heeb 2864' Br li 2978'
Lans. 2992' Cong. 3283'
DST 3240-98, 1 hr, 80' M VSSO 750#
Drilling

5/14 Spud 4-28-52
D&A TD 3345
8" @200 Anhy 520 Heeb. 2864
Br Lime 2978 Lans. 2992 Cong. 3283
DST 3240-98 opn 1 hr. Rec. 80' mid
vsso Arb. 3321 TD 3345 D&A

ABANDONED

County Barton State Kansas

Sec. 25 (Blk. Twp.) 18 (Sur. Rge.) 11W Map No.

Operator Alpine Oil & Royalty

Well No. 1 Farm Randenburg

Elev. _____ Location NW NW NW

| | | | | | |
|---|--|--|--|--|--|
| e | | | | | |
| | | | | | |
| | | | | | |
| | | | | | |
| | | | | | |
| | | | | | |

330 Ft. From N Line NW

330 Ft. From W Line Quarter

Ist. Report APR 30 1952

Completion _____

Remarks Shell & Derby-support

Spudding Date 4-28-52

Drlg. Data _____

8" ● 200 D-1g. 440

J. G. McGEHEE

County Barton State Kansas

Sec. 25 (Blk. Twp.) 18 (Sur. Rge.) 11W Map No.

Operator Alpine Oil & Royalty

Well No. 1 Farm Randenburg

Elev. 1755 Location NW NW NW

| | | | | | |
|---|--|--|--|--|--|
| 0 | | | | | |
| | | | | | |
| | | | | | |
| | | | | | |
| | | | | | |
| | | | | | |
| | | | | | |
| | | | | | |
| | | | | | |
| | | | | | |

330 Ft. From N Line NW

330 Ft. From W Line Quarter

1st. Report

Completion MAY 14 1952

Remarks

Spudding Date 4-28-52

Drig. Data D & A TD 3345

8" @ 200 Anhy 520 Heeb. 2864

Br. lime 2978 Lans. 2992 Cong. 3283

DST 3240-98 open 1 hr. Rec. 80' mud

vss0 Arb. 3321 TD 3345

D & A

J.G. MCGEHEE