

KANSAS

Form 51-5M-7-40-Palace


Barton

Section 7 Township 20 Range 11-W

Well No. ~~#2~~ Petz ~~#3~~

Company Texas

NORTH Ellinwood Pool

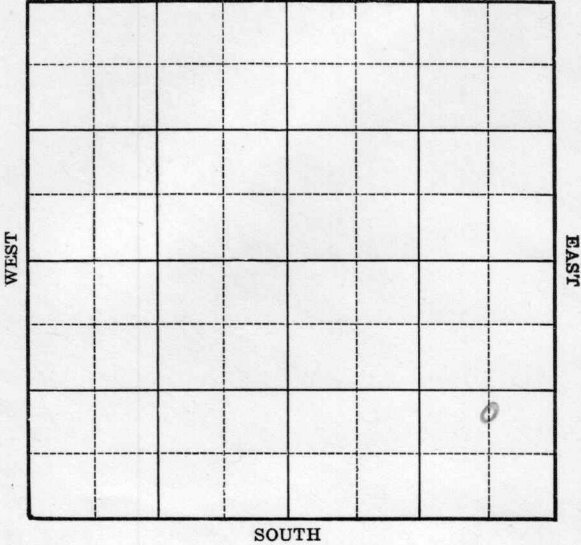

Sec. 7 Twp. 20 R. 11-W

Well No. #3 Petz Farm _____

Texas

Company _____

(Ellinwood)


_____ Ft. from N. Line

1000 Ft. from S. Line

660 Ft. from E. Line

_____ Ft. from W. Line

Elev. 1780

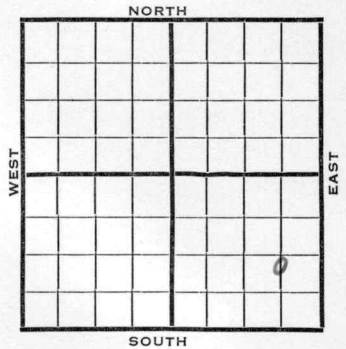

1940	REPORT
8/7	Location
8/14	Derrick
8/22	10" - 281' Drlg. 2160'
8/29	Lans. 3075' Arb. 3296½' T.D. 3299' 7" - 3299' RUST.
9/4	Arb. 3296½' 7" - 3299' T.D. 3316' Echometer potential 3427 bbls. Maximum 3000 bbls.
	COMPLETED

Map No. 46 Sec. 7 Twp. 20 R. 11W

Well No. 3 Petz

Texas

Company _____

Contractor _____

FIRST REPORT

C N L SE SE

SECTION PLAT

			o

_____ Ft. from N. Line

1000 Ft. from S. Line

660 Ft. from E. Line

_____ Ft. from W. Line

ELLINWOOD POOL

Location X

Rig up _____

Drilling and Remarks:

RECORD

Cased _____ in., _____ ft.

Sand _____

Gas _____

Oil _____

Total Depth _____

PRODUCTION

1st 24 hrs. Nat. _____

1st 24 hrs. after shot _____

Gas _____ Cu. Ft.

Dry Hole _____

Abandoned _____

Date

AUG 7 1940 19 _____

S. J. LEWIS Scout

Map No. _____ Sec. 7 Twp. 20 R. 11W

Well No. 3 Petz

Texas

Company _____

Contractor _____

COMPLETED

SECTION PLAT

C N L SE SE

_____ Ft. from N. Line

1000 Ft. from S. Line

660 Ft. from E. Line

_____ Ft. from W. Line

ELLINWOOD POOL

			o

Location _____

Rig up _____

Drilling and Remarks:

CR & 3296 1/2

7" @ 3299

Echo meter P & J

3427

RECORD

Cased _____ in., _____ ft.

Sand _____

Gas _____

Oil _____

Total Depth 3316

PRODUCTION

1st 24 hrs. Nat. _____

1st 24 hrs. after shot _____

Gas _____ Cu. Ft.

Dry Hole _____

Abandoned _____

Date

SEP 4 1940 19

S. J. LEWIS Scout