FORM 51 10M 8-47


KANSAS Barton

Section 26 Township 18 Range 11W

Well No. #1 Robl

Company Derby Oil

Ames Pool

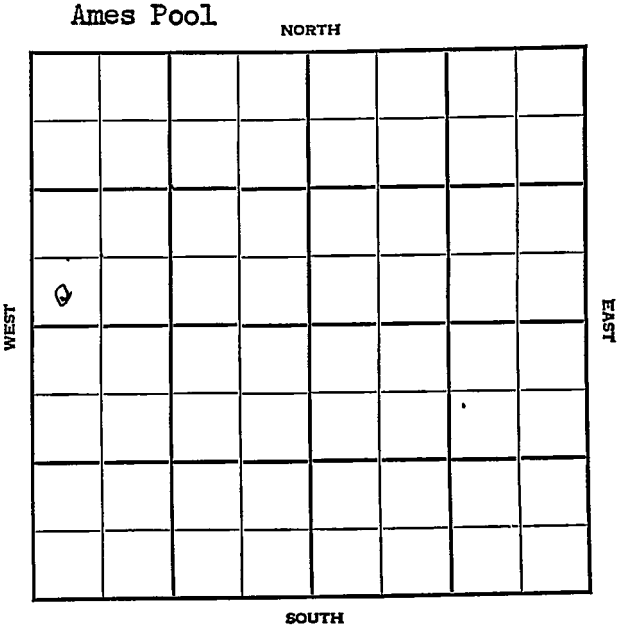

FORM 252-A
5M 9-47 PETROL

KANSAS

Sec. 26 Twp. 18 R. 11W Barton

Well No. #1 Robl Farm

Derby Oil Company

Ames Pool


_____ Ft. from N. Line

330' Ft. from S. Line

_____ Ft. from E. Line

330' Ft. from W. Line

SW NW

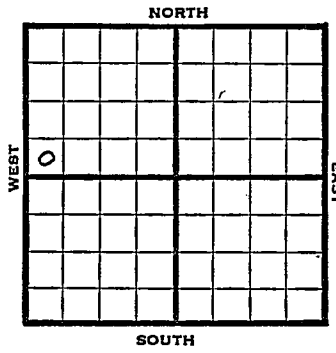

1948	Elev. 1774' REPORT
3/17	Location
3/24	8" @ 350' Drlg. 1525'
3/31	Lansing 3017' Drlg. 3238'
4/7	Arbuckle 3329' TD 3375'
	ABANDONED

Form 26—200 Bks.—1-48—Palace

Ames Pool

Kansas

Map No. _____ Sec. 26 Twp. 18 R. 11W


Well No. 1 Robl

Derby Oil Company

FIRST REPORT Contractor

SW NW

SECTION PLAT

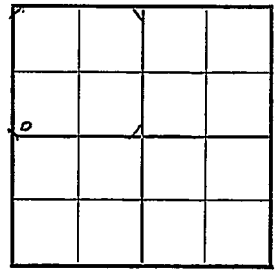

_____ Ft. from N. Line

330 Ft. from S. Line

_____ Ft. from E. Line

330 Ft. from W. Line

Barton County

Location x

Rig up

Drilling and Remarks:

RECORD

Cased _____ in., _____ ft.

Sand

Gas

Oil

Total Depth

PRODUCTION

1st 24 hrs. Nat.

1st 24 hrs. after shot

Gas _____ Cu. Ft.

Dry Hole

Abandoned

Date

MAR 17 1948 19

S. J. LEWIS Scout

Form 26—200 Bks.—1-48—Palace

Ames Pool

Kansas

Map No. 55 Sec. 26 Twp. 18 R. 11W

Well No. 1 Röbl


Derby Oil Company

ABANDONED Contractor

SW NW

E/1774

SECTION PLAT

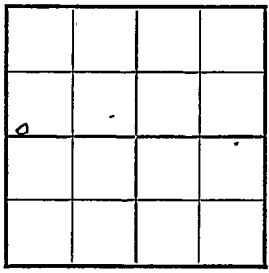

____ Ft. from N. Line

330 Ft. from S. Line

____ Ft. from E. Line

330 Ft. from W. Line

Barton County

Location

Rig up

Drilling and Remarks:

CR 93329

RECORD

Cased ____ in., ____ ft.

Sand

Gas

Oil

Total Depth 3375

PRODUCTION

1st 24 hrs. Nat.

1st 24 hrs. after shot

Gas ____ Cu. Ft.

Dry Hole

Abandoned

Date

APR 7 1948 19

S. J. LEWIS Scout