
FORM 51 25M 3-49 PETROL Barton KANSAS

Section 26 Township 18 Range 11W

Well No. #4 Robl

Company Derby Oil & Pickerall Drlg.

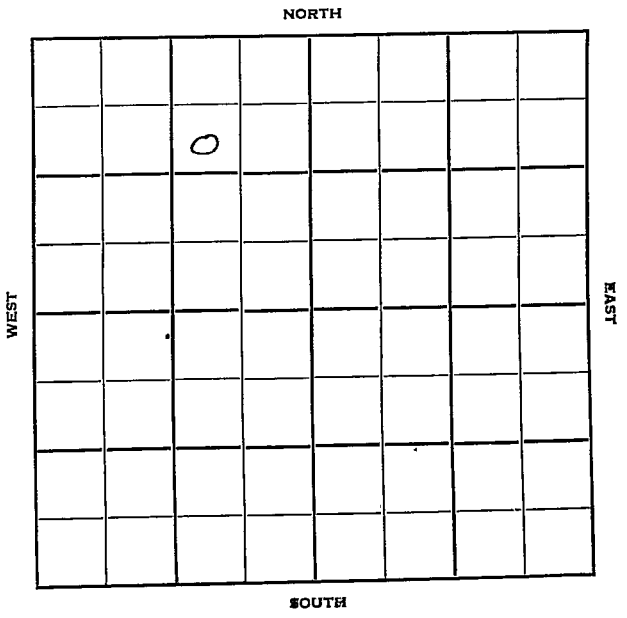

FORM 252-B
10M 8-51 TPCO.

Barton KANSAS

Sec. 26 Twp. 18 R. 11W

Well No. #4 Robi Farm

Derby Oil & Pickerall Drlg. Company

Pickerall - Contr. Contractor


990' Ft. from N. Line

Ft. from S. Line

990' Ft. from E. Line

Ft. from W. Line

SW NE NW

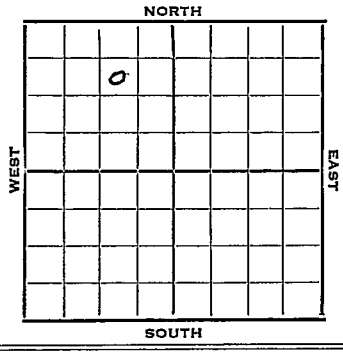

1952	Elev. 1760' REPORT
5/7	Spud 5-6-52
5/14	Heeb. 2873 Br Li 2988 Lans. 3003 DST 3007-70 1 hr. 30' OCM 80# DST 3080-3100 1/2 hr. 10' M 450# DST 3181-94 1 hr. 35' M 750# Drlg. 3270'
5/21	Spud 5-6-52 D & A TD 3335' Heeb 2873' Br. lime 2988' Lans. 3003' DST 3007-70 open 1 hr. rec 30' OCM DST 3080-3100 open ½ hr. rec 10' mud DST 3181-94 open 1 hr. rec 35' mud Simp. 3294' Arb. 3307' TD 3335' D & A **ABANDONED**

FORM 275 FOR SALE BY KANSAS BLUE PRINT CO.


County Barton State Kansas

Sec. 26 (Blk. Twp.) 18 (Sur. Rge.) 11W Map No.

Operator Derby Oil & Pickerall Drlg.

Well No. 4 Farm Robl

Elev. Location SW NE NW

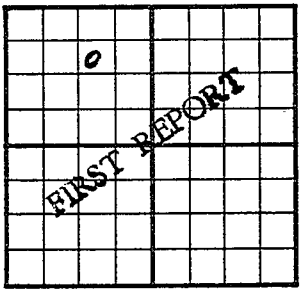

990 Ft. From N Line NW

990 Ft. From E Line Quarter

1st. Report MAY 7 1952

Completion

Remarks

Pickerall - Contr.

Spudding Date 5-6-52

Drlg. Data

J. G. McGEHEE

FORM 275 FOR SALE BY KANSAS BLUE PRINT CO.


County Barton State Kansas

Sec. 26 (Blk. Twp.) 18 (Sur. Rge.) 11W Map No.

Operator Derby Oil & Pickrell Drlg.

Well No. 4 Farm Robl

Elev. 1760 Location SW NE NW

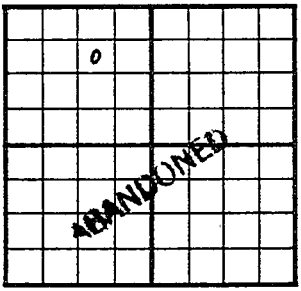

990 Ft. From N Line NW

990 Ft. From E Line Quarter

1st. Report

Completion MAY 21 1952

Remarks

Pickrell Drlg. - Contr.

Spudding Date 5-6-52

Drlg. Data D & A TD 3335

Heeb. 2873 Br. lime 2988 Lans. 3003

DST 3007-70 open 1 hr. Rec. 30' ocm

DST 3080-3100 open ½ hr. Rec. 10' mud

DST 3181-94 open 1 hr. Rec. 35' mud

Simp. 3294 Arb. 3307 TD 3335

D & A

J. G. McGEHEE