

KANSAS

Barton


FORM 51 5M 10-41 PETROL

Section 7 Township 20 Range 11-W

Well No. #4 Schartz "B"

Company C. E. Ash

NORTH Silica Pool

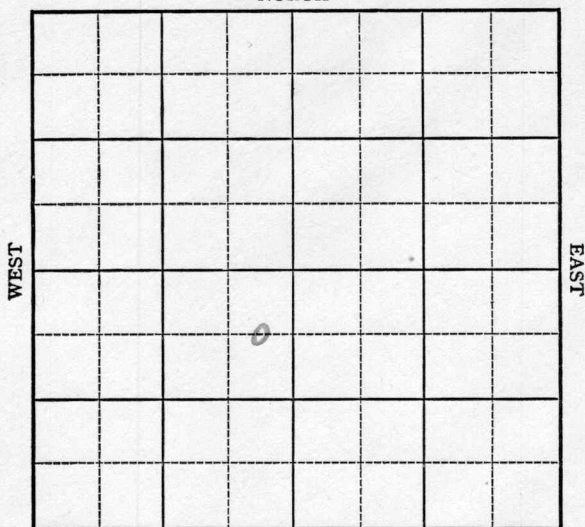

SOUTH

Map No. 46 Sec. 7- Twp. 20 R. 11WWell No. 4 Scharzt "B"

C. E. Ash Company

FIRST REPORT

Contractor

C E L N E S W


SECTION PLAT

660 Ft. from N. Line

Ft. from S. Line

330 Ft. from E. Line

Ft. from W. Line

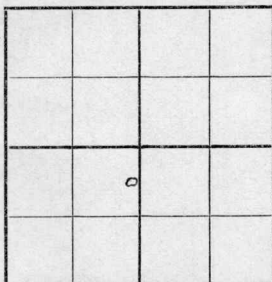

SILICA POOL

Location

Rig up

Drilling and Remarks:

Drlg. 245'

RECORD

Cased in., ft.

Sand

Gas

Oil

Total Depth

PRODUCTION

1st 24 hrs. Nat.

1st 24 hrs. after shot

Gas Cu. Ft.

Dry Hole

Abandoned

Date

APR 15 1942

19

S. J. LEWIS

Scout

Barton

KANSAS

Map No. 46 Sec. 7 Twp. 20 R. 11WWell No. 4 Scharzt "B"C. E. Ash CompanyCOMPLETED Contractor

C EL NE SW

660 Ft. from N. Line Ft. from S. Line330 Ft. from E. Line Ft. from W. Line

SECTION PLAT

SI LICA POOL

Location Rig up

Drilling and Remarks:


RECORD

Cased in., ft.Sand Gas Oil Total Depth 3321

PRODUCTION

1st 24 hrs. Nat. 1st 24 hrs. after shot Gas Cu. Ft.Dry Hole Abandoned

Date

JUN 17 1942 19S. J. LEWIS

Scout