
Barton **KANSAS**

SECTION 27 TOWNSHIP 18 RANGE 11W

WELL NO. #1 Doll "C"

COMPANY Bennett & Roberts

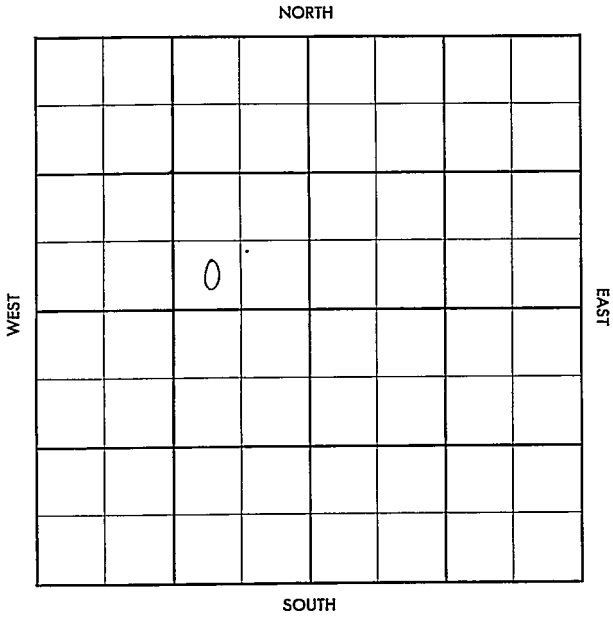

FORM 504-3 SUNRAY

FORM 513 SUNRAY

County Barton Elev.

Sec. 27 Twp. 18 Rge. 11W

Company Bennett & Roberts

Farm Name Doll "C" No. 1

TOPS	DEPTH	LOG	DATUM
Anh.			
Tp.			
H.			
Tr.			
Dg.			
Bl.			
L.			
K.C.			
B.K.C.			
Ce.			
C.			
M.			
M.			
K.			
Mz.			
Mg.			
V.			
S.			
S.			
A			
R.			
P€.			
G.			
T.D.			

Loc. in Sec. SW SE NW

Geol.

Contr. Co. tools

Pool Ames

FIRST REPORT

Date Comm. 7-11-58

8" @ 152/175 drlg. 2670

43

Co. Lse. No. Sec. T. R.

FORM 513 SUNRAY

County Barton Elev. 1787

Sec. 27 Twp. 18 Rge. 11W

Company Bennett & Roberts

Farm Name Doll "C" No. 1

TOPS	DEPTH	LOG	DATUM
Anh.			
Tp.			
H.	2916		
Tr. Dodge	2933		
Dg. Og	2993		
Bl.			
L.	3051		
K.C.			
B.K.C.			
Ce.			
C.	3344		
M.			
M.			
K.			
Mz.			
Mo.			
V.			
S.			
S.			
A	3361		
R.			
Pe.			
G.			
T.D.	3371		

Loc. in Sec. SW SE NW

Geol.

Contr. Co. tools

Pool Ames

COMPLETE

0

FEB 13 '57

Date Comm. 1-11-57

8" @ 152/175 drlg. 2670 JAN 23 '57

DST 3109-44 1hr rec 30' HOCM + 30' Mdy oil + 60' clean oil + 240' Fthy oil. IFP 25/20 FFP 320 JAN 30 '57

5½ @ 3370. RUCT FEB 6 '57

CO OD 3381 PB 1½ BOPH + 3 BWPH DD 3391 TD no inc

RB 3150 18/3/14-17 # 20 BOPH #2 # 3½ BFPH #3 # 4 BFPH

FORM 513-1 SUNRAY

33⅓ wtr Pol FEB 13 '57 P. 25
Bond + 33⅓ wtr.

27-33-11W