


Section 9 Township 20 Range 11-W

Well No. #1 Harter

Company Phil-Han

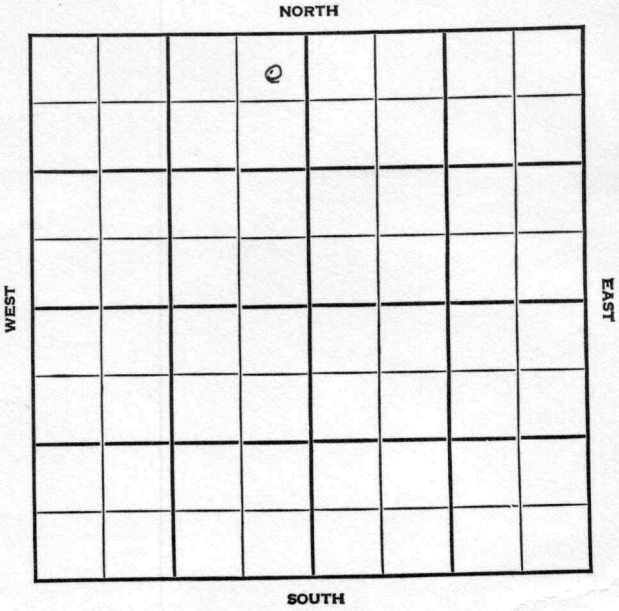

Sec. 9 Twp. 20 R. 11W ✓

Well No. #1 Harter Farm _____

Phil-Hen Company _____

Silica Pool


330' Ft. from N. Line

_____ Ft. from S. Line

330' Ft. from E. Line

_____ Ft. from W. Line

NE NW

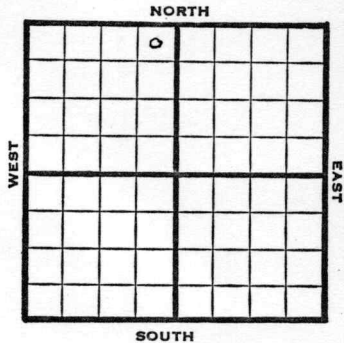

1948 E li 1770' REPORT

6/30	Location
7/8	8"@ 150' Drlg 2425'
7/14	Lansing 3050(Arbuckle 3304-11' TD 3311' Run 5"
8/21	"
7/28	5"@ 3304' TD 3311 1000 acid 8 qts CO
8/4	2000 acid Pump 2 oil PH 24 hrs. SW
8/11	"
8/18	"
8/25	Arb. 3304' 5"@ 3304' TD 3311' 3000 acid Pump 50 oil pot 42° Gr. Comp COMPLETED

Map No. _____ Sec. 9 Twp. 20 R. 11W

Well No. 1 Harter

Phil-Han Company

FIRST REPORT

Contractor

NE NW

330 Ft. from N. Line

_____ Ft. from S. Line

330 Ft. from E. Line

_____ Ft. from W. Line

Barton County

SECTION PLAT

	0		

Location X

Rig up _____

Drilling and Remarks:

RECORD

Cased _____ in., _____ ft.

Sand _____

Gas _____

Oil _____

Total Depth _____

PRODUCTION

1st 24 hrs. Nat. _____

1st 24 hrs. after shot _____

Gas _____ Cu. Ft.

Dry Hole _____

Abandoned _____

Date

JUN 30 1948

19

S. J. LEWIS

Scout

Barton County Kansas State

Map No. 46 Sec. 9 Twp. 20 R. 11W

Well No. 1 Herter

Phil-Han Company

COMPLETE

Contractor

NE NW

E 11770

SECTION PLAT

		0			

330 Ft. from N. Line

Ft. from S. Line

330 Ft. from E. Line

Ft. from W. Line

Silica Pool

Remarks:

Cr 3304

5" @ 3304

773311

8000000

Pump 500 ft Bx

42 1/2

Date

AUG 25 1948

Scout

S. J. LEWIS