
FORM 51 25M 8-50 WESTERN Barton KANSAS

Section 27 Township 18 Range 11W

Well No. #1 Robl

Company Honaker

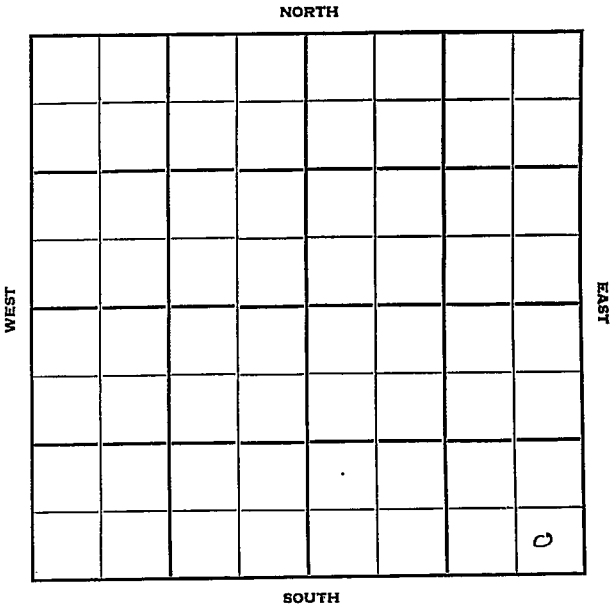

FORM 252-B
10M 10-50 PETROL

Barton KANSAS

Sec. 27 Twp. 18 R. 11W

Well No. #1 Robl Farm

Honaker Company

Honaker- Contr. Contractor
Wildcat


Ft. from N. Line

330' Ft. from S. Line

330' Ft. from E. Line

Ft. from W. Line

SE SE SE

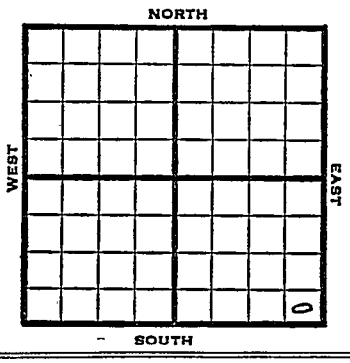

1951	Elev. 1777' REPORT
9/12	RUR
10/3	Spud 9-10-51 D & A TD 3370' 8" @ 192' Top. 2896' Br. lime 3012' Lans 3027'. DST 3073-3105' open 50 min. rec 20' mud. DST 3358- ? open ½ hr. rec 6' mud, Cong. 3323' Arb. 3344' DST 3347-58 open ½ hr. rec 6' mud TD 3370' D & A **ABANDONED**

FORM 275 FOR SALE BY KANSAS BLUE PRINT CO.


County Barton State Kansas

Sec. 27 (Blk. Twp.) 18 (Sur. Rge.) 11W Map No.

Operator Honaker

Well No. 1 Farm Robl

Elev. Location SE SE SE

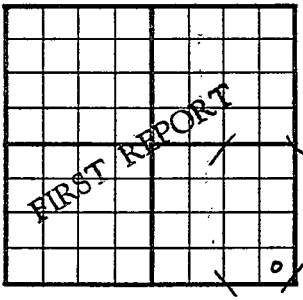

330 Ft. From S Line SE

330 Ft. From E Line Quarter

1st. Report SEP 12 1951

Completion

Remarks

Honaker - Contr.

Spudding Date

Drlg. Data Wildcat

RUR

J. E. TYRA

FORM 275 FOR SALE BY KANSAS BLUE PRINT CO.


County Barton State Kansas

Sec. 27 (Blk. Twp.) 18 (Sur. Rge.) 11W Map No.

Operator Honaker Drlg.

Well No. 1 Farm Robl

Elev. 1777 Location SE SE SE

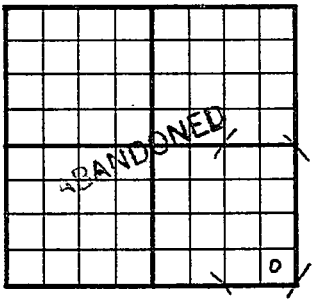

330 Ft. From S Line SE

330 Ft. From E Line Quarter

1st. Report

Completion OCT 3 1951

Remarks Wildcat

Honaker Drlg. - Contr.

Spudding Date 9-10-51

Drlg. Data D & A TD 3370

8" @ 192 Top. 2896 Br. lime 3012

Lans. 3027 DST 3073-3105 open 50 min.

Rec. 20' mud DST 3358- ? open ½ hr.

Rec. 6' mud Cong. 3323 Arb. 3344

DST 3347-58 open ½ hr. Rec. 6' mud

TD 3370 D & A

J. E. TYRA