
KANSAS
FORM PST SM 1-42 PETROL

Barton

Section 27 Township 18 Range 11-W

Well No. #2 Robl

Company Alco Valve

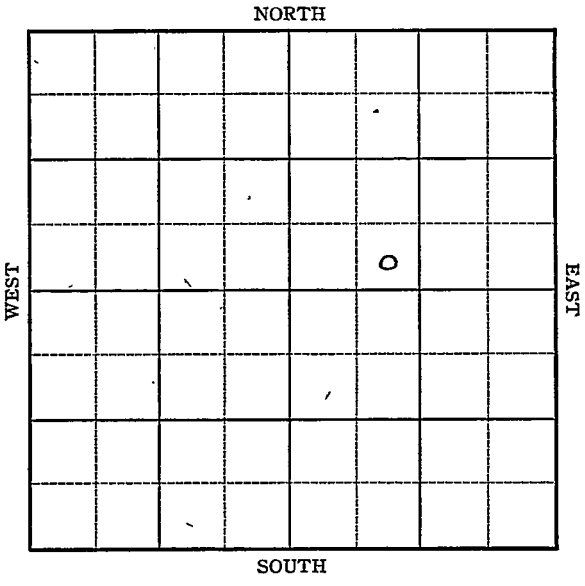


FORM 252-A
5M 9-43 GASS KANSAS

Barton

Sec. 27 Twp. 18 R. 11-W

Well No. #2 Robl Farm

Alco Valve Company

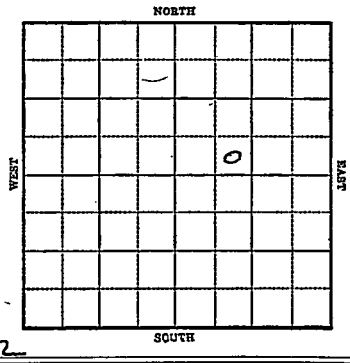

_____ Ft. from N. Line

330 Ft. from S. Line

_____ Ft. from E. Line

990 Ft. from W. Line

Elev. 1782

1946	REPORT
1/5	Anhy 570 8" @ 574 Drlg. 1680
1-12	Lans 3035 Drlg 3050'
1/19	BKC 3301 Cong 3315 Arb 3340 TD 3353 PB 3070 5" @ 3055 Rust
1/26	"
2/2	5" @ 3055 Arb 3340 TD 3353 3100 acid Water SO

ABANDONED

Form 26 200-Bks 5-42 Petrol Barton

KANSAS

Map No.)) Sec. 27 Twp. 18 R. 11W


Well No. 2 Robl

Also Valve Company

FIRST REPORT Contractor

SE SW NE

SECTION PLAT

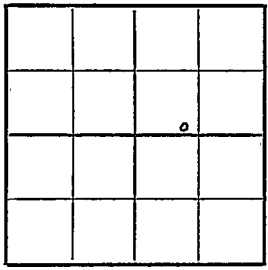

____ Ft. from N. Line

330 Ft. from S. Line

____ Ft. from E. Line

990 Ft. from W. Line

AMES POOL

Location

Rig up

Drilling and Remarks:

Anhy 570

8" - 574

Drlg. 1680

RECORD

Cased ____ in., ____ ft.

Sand

Gas

Oil

Total Depth

PRODUCTION

1st 24 hrs. Nat.

1st 24 hrs. after shot

Gas ____ Cu. Ft.

Dry Hole

Abandoned

Date

JAN 5 1944 19 S. J. LEWIS Scout

Form 26 200 Bks 5-42 Petrol Barton

KANSAS

Map No. Sec. 27 Twp. 18 R. 11W

Well No. 2 Robl


Alco Valve Company

ABANDONED

Contractor

SE SW NE

SECTION PLAT

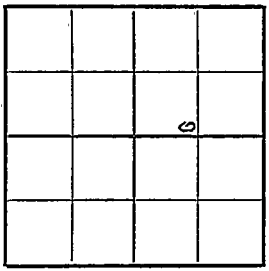

Ft. from N. Line

330 Ft. from S. Line

Ft. from E. Line

990 Ft. from W. Line

Ames Pool

Location

Rig up

Drilling and Remarks:

Cer #3340

5 "C" 2055

3100 acid

Water 80.

RECORD

Cased in., ft.

Sand

Gas

Oil

Total Depth 3325'

PRODUCTION

1st 24 hrs. Nat.

1st 24 hrs. after shot

Gas Cu. Ft.

Dry Hole

Abandoned

Date

FEB 2 1944 19

S. J. LEWIS Scout