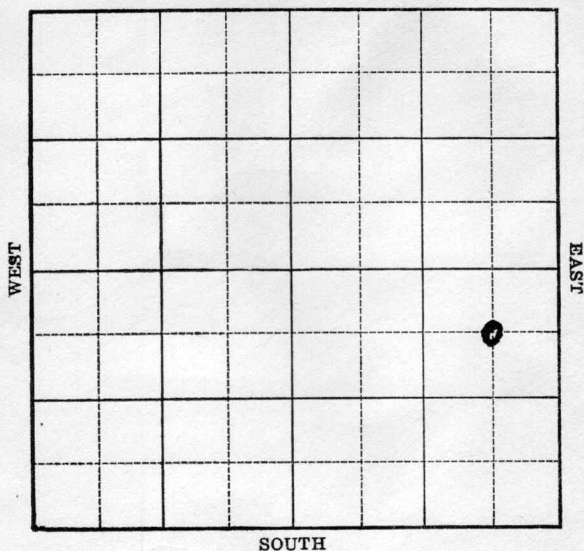


Section 9 Township 20 Range 11-WWell No. 4 ScheuflerCompany StanolindNORTH Ellinwood Pool

Barton

KANSAS

Map No. 16 Sec. 9 Twp. 20 R. 11WWell No. 4 Scheufler

Stanolind

Company

Contractor

FIRST REPORT

SECTION PLAT

660 C NE SE
Ft. from N. Line

Ft. from S. Line

660 Ft. from E. Line

Ft. from W. Line

ELLINWOOD POOL

			0

Location _____

Rig up _____

Drilling and Remarks:

RUR

RECORD

Cased _____ in., _____ ft.

Sand _____

Gas _____

Oil _____

Total Depth _____

PRODUCTION

1st 24 hrs. Nat. _____

1st 24 hrs. after shot _____

Gas _____ Cu. Ft.

Dry Hole _____

Abandoned _____

Date

APR 12 1939

19

H. D. Hatfield

Scout

Barton

KANSAS

Map No. 46 Sec. 9 Twp. 20 R. 11WWell No. 4 Scheufler

Stanolind

Company

Contractor

ABANDONED

C NE SE

SECTION PLAT

			o

660 Ft. from N. Line

Ft. from S. Line

660 Ft. from E. Line

Ft. from W. Line

ELLINWOOD POOL

Location _____

Rig up _____

Drilling and Remarks:

*Lang. 3050**Crk. 3308 1/2**7" @ 3309**500 acid**200' Water.*

RECORD

Cased _____ in., _____ ft.

Sand _____

Gas _____

Oil _____

Total Depth 3320

PRODUCTION

1st 24 hrs. Nat. _____

1st 24 hrs. after shot _____

Gas _____ Cu. Ft.

Dry Hole _____

Abandoned _____

Date

MAY 10 1939

19

S. J. LEWIS

Scout