


Section 27 Township 18 Range 11WWell No. #1 Robl "A"Company Derby Oil et al

NORTH

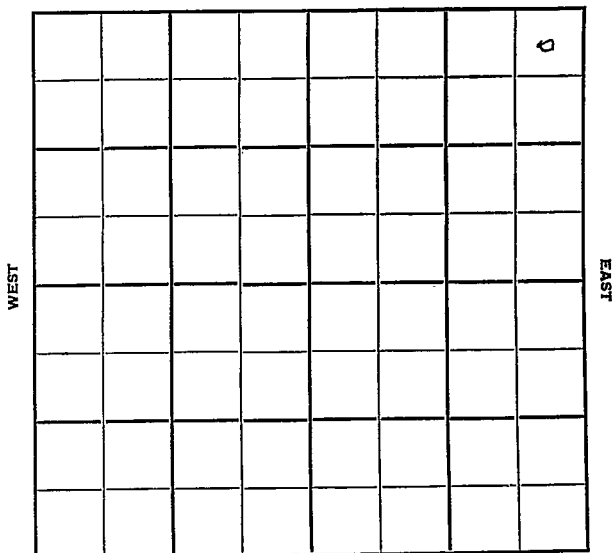

SOUTH

Barton

KANSAS

Sec. 27 Twp. 18 R. 11W

Well No. #1 Robt "A" Farm

Derby Oil et al Company

Pickrell Drlg. -Contr. Contractor

Ames Pool


330' Ft. from N. Line

 Ft. from S. Line

330' Ft. from E. Line

 Ft. from W. Line

NE NE NE

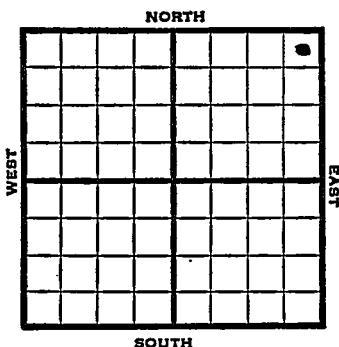

1951

Elev. 1775' REPORT

3/21

Spud 3-19-51
8" @ 194
WOC

5/2

Spud 3-19-51
Oil well TD 3326' 8" @ 194
Lans. 3012'
DST 3028-70 open 1 hr. rec 1500' gas
85' OCM
DST 3078-95 open 1 hr. rec 960' gas
350' O & GCM
Arb. 3308-15 4 1/2" @ 3310 TD 3326
25 EO 19 GWPH 500 A S/18 BFPH
14% oil FU 1750' fluid 9 hr.
Comp. 115 BOPD 4 BW

COMPLETED



Operator **Derby Oil etal.**

Well No. 1 Farm Robt "A"

Elev.	Location	NE	NE	NE
-------	----------	----	----	----

0

FIRST REPORT

330 Ft. From N Line NE

330 Ft. From E Line Quarter

1st. Report MAR 21 1951

Completion

Remarks

Pickrell Drlg. - Contr.

Spudding Date **3-19-51**

Drig. Data Ames Pool

8" @ 194 WOC

