
Form 51—5M—3-35—Mid-West

Map No. KANSAS Sec. 28 Twp. 18 R. 11W Barton

Well No. 1 Kenz Farm

Derby Oil Company

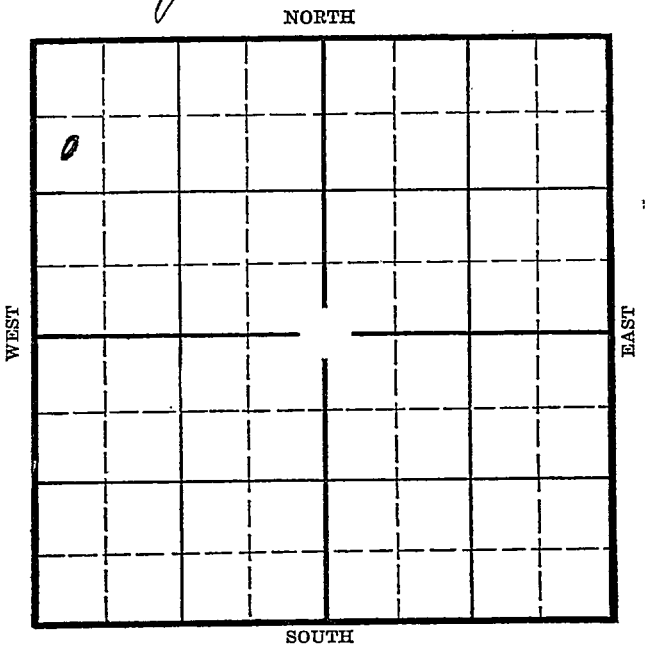

Location

Drilling Remarks

Rig Up

Drilling Remarks

RECORD

Cased ____ in. ____ ft.

Sand

Gas

Oil

Total Depth

PRODUCTION

1st 24 hrs. Nat.

1st 24 hrs. after shot

Gas ____ cu. ft.

Dry Hole

Abandoned

Form 252-A
5M 7-35 MPC

Barton

Map No. KANSAS Sec. 28 Twp. 18 R. 11W

Well No. 1 Heinz Farm


Derby Oil Company

990 Ft. from N. Line

_____ Ft. from S. Line

_____ Ft. from E. Line

330 Ft. from W. Line

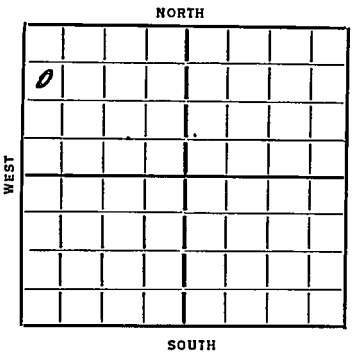

Elev. 1816

Date	REPORT
1935	
12/11	Cellar
12/19	12" 150 Dlg cmt
12/26	Dlg 1765
1/3/36	" 2660
1/10	Top Lans. 3110
	Coring 3411
1/17	Sand & asphalt 3429-30
	Top Chert 3430-32
	7" 3429 Casing
1/22	Lil 3453
	TD 3487½ HFW
	D & A.
	ABANDONED

Barton

Form 26—1M Bks. 9-28

KANSAS


Map No. 53 Sec. 28 Twp. 18 R. 11W

Well No. 1 - Heinz

Derby Oil Company

Contractor

SECTION PLAT

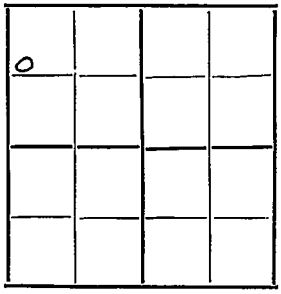

990 Ft. from N. Line

Ft. from S. Line

Ft. from E. Line

330 Ft. from W. Line

COMPLETED

Location

Rig up

Drilling and Remarks:

hfw.

D+A

RECORD

Cased in., ft.

Sand Sil. 3453

Gas

Oil

Total Depth 3487½

PRODUCTION

1st 24 hrs. Nat.

1st 24 hrs. after shot

Gas Cu. Ft.

Dry Hole

Abandoned

Date

JAN 22 1936

192

OVAL MANNSCHRECK Scout

Barton

Form 26—1M Bks. 9-28 KANSAS

Map No. 53 Sec. 28 Twp. 18 R. 11W


Well No. 1- Heinz

Derby Oil Company

Contractor

MOST REPORTS

SECTION PLAT

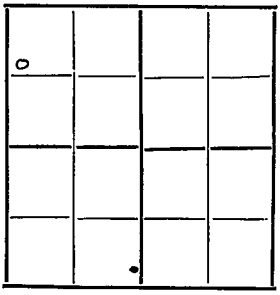

990 Ft. from N. Line

Ft. from S. Line

Ft. from E. Line

330 Ft. from W. Line

Location

Rig up

Drilling and Remarks:

Cellar

RECORD

Cased in., ft.

Sand

Gas

Oil

Total Depth

PRODUCTION

1st 24 hrs. Nat.

1st 24 hrs. after shot

Gas Cu. Ft.

Dry Hole

Abandoned

Date

12-11-35 192

ORVAL MANNSCHRECK Scout