


Barton

Section 3 Township 18 Range 14W

Well No. #5 L. Harper

Company Texas

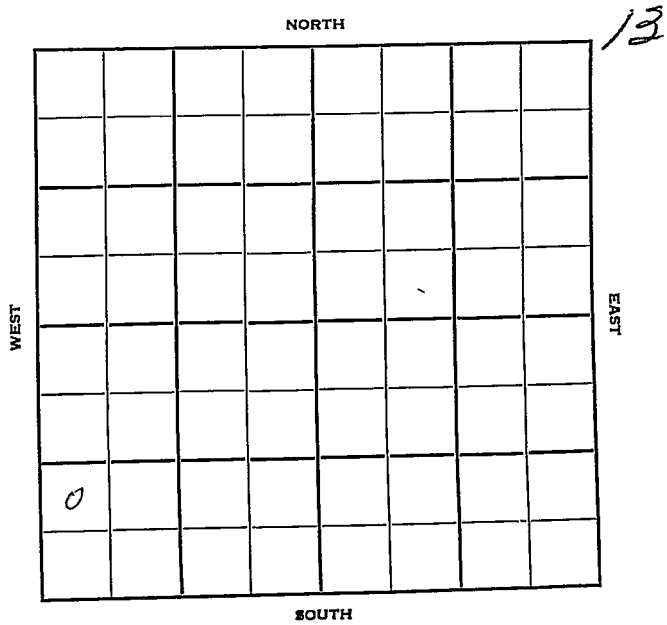

Barton

KANSAS

Sec. 3 Twp. 18 R. 14W ✓

Well No. #5 L. Harper Farm

Texas

Company

Contractor

Boyd Pool

Ft. from N. Line

990'


Ft. from S. Line

Ft. from E. Line

330'

Ft. from W. Line

NW SW SW

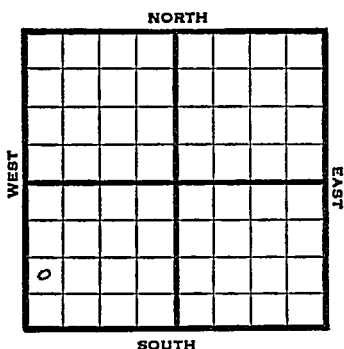

1950	Elev 1905' REPORT
4/12	10-3/4" @ 868' WOC
5/3	TD 3391' 10 3/4" @ 868' Lans 3149' Cong 3364' Arb. 3386' 7"@ 3387' 498 BOPD Comp
	COMPLETED

Kansas

Boyd Pool

Map No. _____ Sec. 3 Twp. 18 R. 14WWell No. 5 L. Harper

_____ Texas _____ Company

_____ Contractor


NW SW SW

SECTION PLAT

_____ Ft. from N. Line

990 Ft. from S. Line

_____ Ft. from E. Line

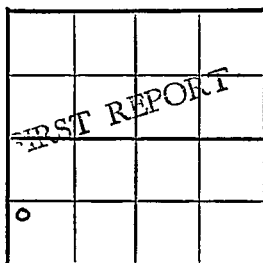330 Ft. from W. Line

Barton County

Location _____

Rig up _____

Drilling and Remarks:

10 3/4" @ 868WOC

RECORD

Cased _____ in., _____ ft.

Sand _____

Gas _____

Oil _____

Total Depth _____

PRODUCTION

1st 24 hrs. Nat. _____

1st 24 hrs. after shot _____

Gas _____ Cu. Ft.

Dry Hole _____

Abandoned _____

Date

APR 12 1950 19 J. E. TYRA Scout

Kansas

Bryd Pool

Map No. _____ Sec. 3 Twp. 18 R. 14WWell No. 5 L. Harper

_____ Texas _____ Company


_____ Contractor

NW ST STHE. 1905
SECTION PLAT

_____ Ft. from N. Line

990 Ft. from S. Line

_____ Ft. from E. Line

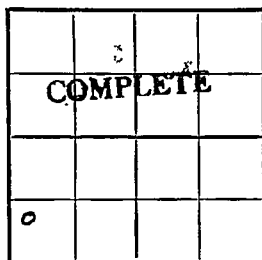330 Ft. from W. Line

Barton County

Location _____

Rig up _____

Drilling and Remarks:

10 3/4 @ 868San 3149cong 3364arb 33867" @ 3387498 BOPD

RECORD

Cased _____ in., _____ ft.

Sand _____

Gas _____

Oil _____

Total Depth 3391

PRODUCTION

1st 24 hrs. Nat. _____

1st 24 hrs. after shot _____

Gas _____ Cu. Ft.

Dry Hole _____

Abandoned _____

Date

MAY 3 1950 19

J. E. TYRA

Scout