


Barton
KANSAS

Section 28 Township 18 Range 11W

Well No. 1 Schlochermer

Company E. Jonas

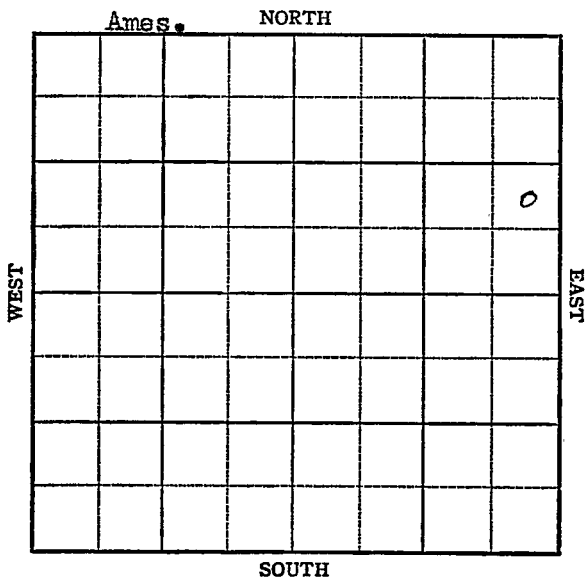

Sec. 28 Twp. 18 R. 11W

Well No. #1 Schloctermeyer Farm

E. Jonas Company

Ames


 Ft. from N. Line

990 Ft. from S. Line

330 Ft. from E. Line

 Ft. from W. Line

NE SE NE

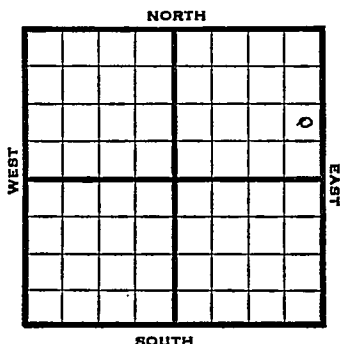

1947	Elev. 1794' REPORT
8/27	Drlg. 343'
9/3	" 2247'
9/10	Dlrg. 3332'
9/17	Tight hole.
9/24	"
10/1	"
10/8	"
10/15	"
10/22	"
10/29	"
11/5	Lansing 3070' TD 3350' 5" @ 3180' 70 shots 3097-3106 45 " 3072-3128
11/12	"
11/19	"
11/25	"
12/3	"

OVER

1947

12/10 Lansing 3080'
 TD 3350'
 5" @ 3180'
 70 shots 3097'-3106' ~~45~~
45 shots 3072-3128'

12/17 "

12/30 "

1948
1/7 "

1/14 Lans. 3070'
 TD 3350'
 Abd.

ABANDONED

Map No. _____ Sec. 28 Twp. 18 R. 11W

Well No. 1 Schloctermeyer

E. Jonas Company

FIRST REPORT

Contractor

NE SE NE


SECTION PLAT

_____ Ft. from N. Line

990 Ft. from S. Line

330 Ft. from E. Line

_____ Ft. from W. Line

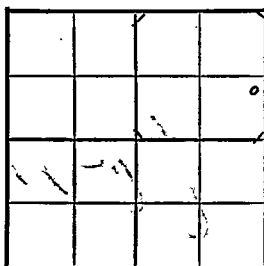

Barton County

Location _____

Rig up _____

Drilling and Remarks:

drlg. 343

RECORD

Cased _____ in., _____ ft.

Sand _____

Gas _____

Oil _____

Total Depth _____

PRODUCTION

1st 24 hrs. Nat. _____

1st 24 hrs. after shot _____

Gas _____ Cu. Ft.

Dry Hole _____

Abandoned _____

Date

AUG 27 1947 19

S. J. LEWIS Scout

Map No. 55 Sec. 28 Twp. 18 R. 11W

Well No. 1 Schloctermeyer

E. Jonas Company

ABANDONED

Contractor

NE SE NE

E11794
SECTION PLAT

 Ft. from N. Line

990 Ft. from S. Line

330 Ft. from E. Line

 Ft. from W. Line

			6

Barton County

Location

Rig up

Drilling and Remarks:

Line 3070

RECORD

Cased in., ft.

Sand

Gas

Oil

Total Depth 3300

PRODUCTION

1st 24 hrs. Nat.

1st 24 hrs. after shot

Gas Cu. Ft.

Dry Hole

Abandoned

Date

JAN 14 1948 19

S. J. LEWIS Scout