

KANSAS

Form 51-5M-7-39-Palace


Barton

Section 10 Township 20 Range 11-W

Well No. #20 Wm. Panning

Company Stanolind

NORTH Silica Pool

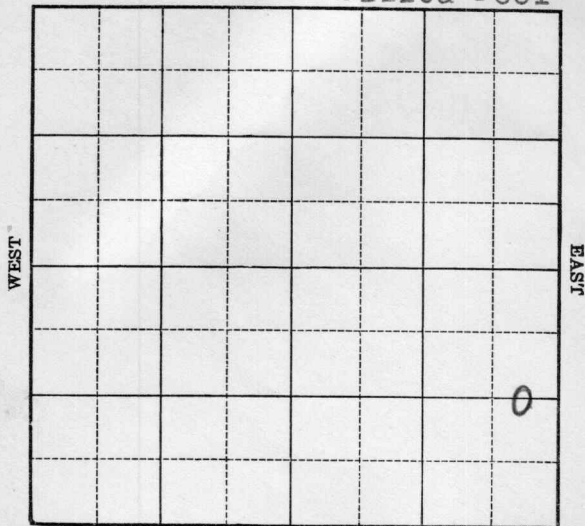


KANSAS

Barton

Sec. 10 Twp. 20 R. 11-WWell No. #20 Wm. Panning FarmStanolind Company

(Silica)

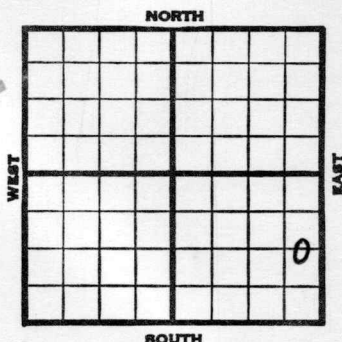 Ft. from N. Line1320 Ft. from S. Line330 Ft. from E. Line Ft. from W. Line

Elev. 1758

1939	REPORT
10/11	Location
10/19	"
10/26	"
11/2	"
11/9	Rotary.
11/16	8" - 216' Anhy 490'
	Drlg. 889'
11/23	Drlg. 3275'
11/29	Arb. 3274' 5" - 3275'
	T.D. 3279' RUST.
12/6	Arb. 3272'
	5" - 3275'
	T.D. 3280'
	1000 acid.
	Depthograph 5309 bbls.
	Maximum 3000 bbls.
	COMPLETED

Map No. 46 Sec. 10 Twp. 20 R. 11WWell No. 20 Wm. PanningStanolind

Company

Contractor

FIRST REPORT

C E L S E

Ft. from N. Line

1320 Ft. from S. Line330 Ft. from E. Line

Ft. from W. Line

SECTION PLAT

			0

SILICA POOL

Location X

Rig up

Drilling and Remarks:

RECORD

Cased _____ in., _____ ft.

Sand _____

Gas _____

Oil _____

Total Depth _____

PRODUCTION

1st 24 hrs. Nat. _____

1st 24 hrs. after shot _____

Gas _____ Cu. Ft.

Dry Hole _____

Abandoned _____

Date

OCT 11 1939

19

S. J. LEWIS

Scout

Map No. 46 Sec. 10 Twp. 20 R. 11WWell No. 20 Wm. PanningStanolind

Company

Contractor

COMPLETED

C E L S E

 Ft. from N. Line1320 Ft. from S. Line330 Ft. from E. Line Ft. from W. Line

SECTION PLAT

SILICA POOL

Location Rig up

Drilling and Remarks:

*Ar 43272**5" @ 3275**1000 acid**Depthograph 5309**Maximum 3000*

RECORD

Cased in., ft.Sand Gas Oil Total Depth 3280

PRODUCTION

1st 24 hrs. Nat. 1st 24 hrs. after shot Gas Cu. Ft.Dry Hole Abandoned

Date

DEC 6 1939

19

S. J. LEWIS

Scout