

KANSAS

Form 51-5M-11-38-Palace


Barton

Section 10 Township 20 Range 11-W

Well No. #22 Wm. Panning

Company Stanolind

NORTH Silica Pool

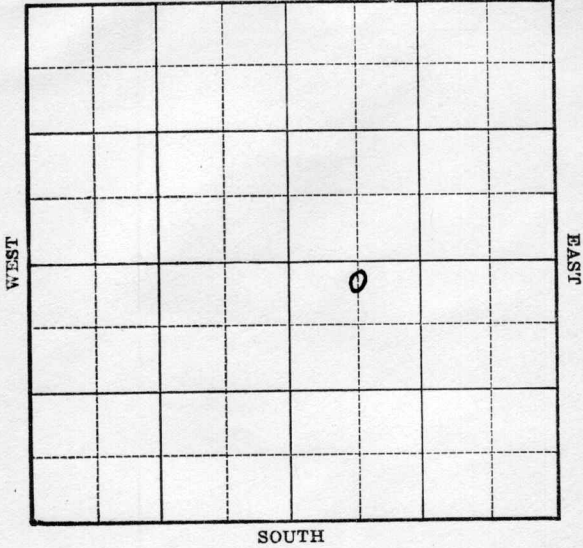

Barton KANSAS

Map No. 46 Sec. 10 Twp. 20 R. 11W

Well No. 22 Wm. Panning

Stanolind Company

FIRST REPORT Contractor

C $N\frac{1}{2}$ NW SE

285 Ft. from N. Line

_____ Ft. from S. Line

_____ Ft. from E. Line

660 Ft. from W. Line

SECTION PLAT

		o	

SILICA POOL

Location X

Rig up _____

Drilling and Remarks:

RECORD

Cased _____ in., _____ ft.

Sand _____

Gas _____

Oil _____

Total Depth _____

PRODUCTION

1st 24 hrs. Nat. _____

1st 24 hrs. after shot _____

Gas _____ Cu. Ft.

Dry Hole _____

Abandoned _____

Date

DEC 27 1939 19

S. J. LEWIS Scout

Map No. 46 Sec. 10 Twp. 20 R. 11W

Well No. 22 Wm. Panning

Stanolind

Company

Contractor

ABANDONED

SECTION PLAT

C $N\frac{1}{2}$ NW SE
285 Ft. from N. Line
 _____ Ft. from S. Line
 _____ Ft. from E. Line
660 Ft. from W. Line

		o	

SILICA POOL

Location _____

Rig up _____

Drilling and Remarks:

Cu & 3298.

5 1/2 @ 3297

No shows

RECORD

Cased _____ in., _____ ft.

Sand _____

Gas _____

Oil _____

Total Depth 3397

PRODUCTION

1st 24 hrs. Nat. _____

1st 24 hrs. after shot _____

Gas _____ Cu. Ft.

Dry Hole _____

Abandoned _____

Date

JAN 31 1940 19

S. J. LEWIS Scout