

Section 4 Township 18 Range 14WWell No. 1 MeitnerCompany G&M-R- Oil & Phillips

NORTH

13

0							

SOUTH

WEST


EAST

Barton

KANSAS ✓

Sec. 4 Twp. 18 R. 14WWell No. #1 Meitner FarmG-M-R Oil & Phillips CompanyG-M-R ContractorBoyd Pool Ft. from N. Line990 Ft. from S. Line Ft. from E. Line330 Ft. from W. Line

NW SW SW

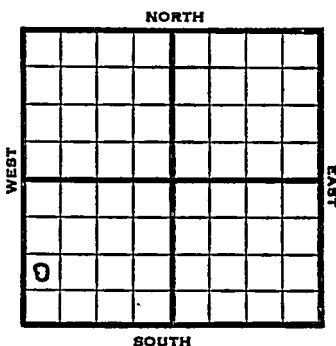

1953

Elev. 1999'

REPORT

7/29

Spud 7-20-53

8" @ 175'

Anhy 955,

Heeb 3170

Lans 3238

Drlg. 3365'

8/5

Spud 7-20-53

D & A

TD 3506'

8" @ 175'

Anhy 955, Heeb 3170, Lans 3238, Cong
3474, Arb 3495DST 3500-06, opn $\frac{1}{2}$ hr, rec 10' ocm
55' ocs 1160#

TD 3506'

D & A

ABANDONED

County **Barton** State **Kansas**

Sec. 4 (Blk. 18) (Sur. 14W) Map No. _____

Operator **G-M-R Oil & Phillips**

Well No. 7 Farm Meitner

Elev.	1999	Location	NW	SW	SW
-------	------	----------	----	----	----

FIRST REPORT

990 Ft. From S Line SW

330 Ft. From W Line Quarter

1st. Report JUL 29 1953

Completion

Remarks

G-M-R - Contr.

Spudding Date 7-20-53


Drig. Data	Boyd Pool
------------	-----------

8th @ 175 Anny 955 Heeb. 3170

Tons. 3238 drls. 3365

J. G. McGEHEE

County Barton State Kansas
 Sec. 4 (Blk.) 18 (Sur.) 14W Map No.
 Operator G-M-R Oil & Phillips
 Well No. 1 Farm Meitner
 Elev. 1999 Location NW SW SW

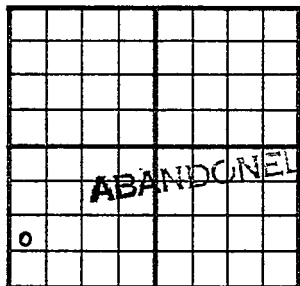

990 Ft. From S Line SW
330 Ft. From W Line Quarter
 1st. Report
 Completion AUG 5 1953
 Remarks Boyd Pool
G-M-R - Contr.
 Spudding Date 7-20-53

Drlg. Data D & A TD 3506
8" @ 175 Anhy 955 Heeb. 3170
Lans. 3238 Cong. 3474 Arb. 3495
DST 3500-06 open $\frac{1}{2}$ hr. Rec. 10' ocm
55' ocs w 1160# TD 3506

D & A

J. G. McGEHEE