

KANSAS

Form 51—5M—7-39—Palace


Barton

Section 10 Township 20 Range 11-W

Well No. ~~#6~~ State #3

Company Derby Oil

NORTH Silica Pool

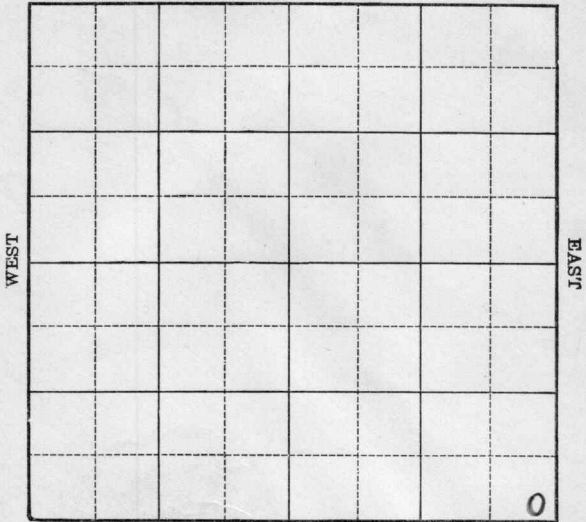

SOUTH

KANSAS

Barton

Sec. 10 Twp. 20 R. 11-WWell No. ~~#6~~ State ~~#~~ 3 Farm _____Derby Oil


Company _____

(Silica)

_____ Ft. from N. Line

100 Ft. from S. Line100 Ft. from E. Line

_____ Ft. from W. Line

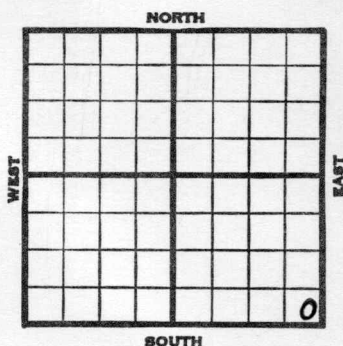

Elev. 1758

1939	REPORT
12/20	Location
12/28	"
1940	
1/4	"
1/11	"
1/18	"
1/25	7" - 253' Drlg. 1717'
2/1	Drlg. 3237'
2/8	Arb. 3281' T.D. 3288' H.F.O.
	4½" - 3281½' Testing.
2/15	2000 acid. Testing.
2/23	Pump 69 bbls. 5 hours. Testing.
2/29	" " " " "
3/6	Arb. 3281'
	4½" - 3281½'
	T.D. 3288'
	2000 acid.
	4000 acid.
	Depthograph potential 823 bbls.
	COMPLETED

Barton

KANSAS

Map No. 46 Sec. 10 Twp. 20 R. 11WWell No. 6 StateDerby Oil

Company

Contractor

SE/C

SECTION PLAT

 Ft. from N. Line100 Ft. from S. Line100 Ft. from E. Line Ft. from W. Line

SILICA POOL

Location XRig up

Drilling and Remarks:

RECORD

Cased in., ft.Sand Gas Oil Total Depth

PRODUCTION

1st 24 hrs. Nat. 1st 24 hrs. after shot Gas Cu. Ft.Dry Hole Abandoned

Date

DEC 20 1939

19

S. J. LEWIS

Scout

Barton

KANSAS

Map No. 46 Sec. 10 Twp. 20 R. 11WWell No. 3 StateDerby Oil

Company

CORRECTION

Contractor

SE/C

SECTION PLAT

			0

 Ft. from N. Line100 Ft. from S. Line100 Ft. from E. Line Ft. from W. Line

SILICA POOL

Location Rig up

Drilling and Remarks:

Reported as #6

RECORD

Cased in., ft.Sand Gas Oil Total Depth

PRODUCTION

1st 24 hrs. Nat. 1st 24 hrs. after shot Gas Cu. Ft.Dry Hole Abandoned

Date

JAN 10 1940 19

S. J. LEWIS

Scout

Barton

KANSAS

Map No. 46 Sec. 10 Twp. 20 R. 11WWell No. 3 StateDerby Oil


Company

Contractor

COMPLETED

SE/C

SECTION PLAT

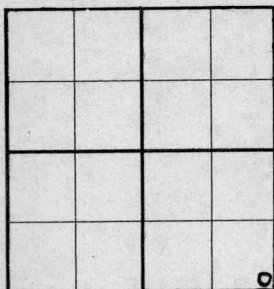 Ft. from N. Line100 Ft. from S. Line100 Ft. from E. Line Ft. from W. Line

SILICA POOL

RECORD

Location Cased in., ft.Rig up Sand buried 3281

Drilling and Remarks:

Gas Oil Total Depth 3288

PRODUCTION

1st 24 hrs. Nat. 1st 24 hrs. after shot Gas Cu. Ft.Dry Hole Abandoned

Date

MAR 6 1940

19

S. J. LEWIS

Scout