

KANSAS


Form 51—5M—7-39—Palace

Barton

Section 10 Township 20 Range 11-W

Well No. #4 State

Company Derby Oil

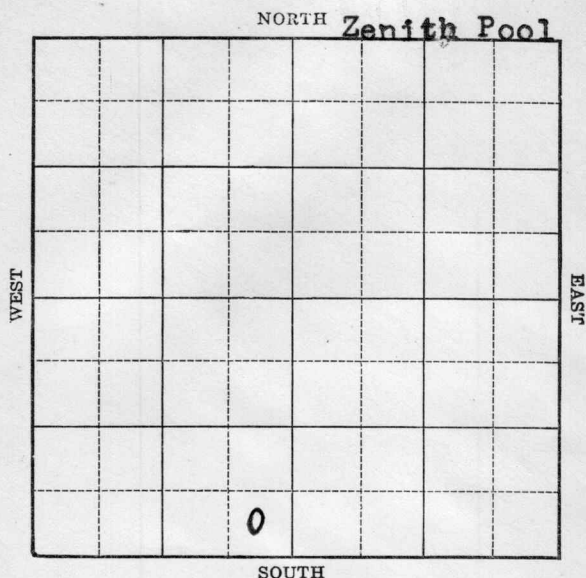


Sec. 10 Twp. 20 R. 11-WWell No. #4 State FarmDerby Oil Company

(Zenith)

 Ft. from N. Line~~330~~ 290
Ft. from S. Line170
~~330~~ Ft. from E. Line Ft. from W. Line

Elev. 1760

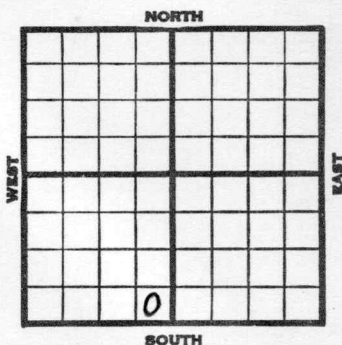

1940	REPORT
1/31	Pits.
2/8	7" - 244'
	Drlg. 1378'
2/15	Drlg. 3050'
2/23	Lans. 3060' Arb. 3287'
	4½" - 3288' T.D. 3291' RUST.
2/29	" " " " " "
3/8	T.D. 3297' Temporary potential 86 bbls.
3/14	" " "
3/21	Shut down.
3/27	Arb. 3287'
	4½" - 3288'
	T.D. 3297'
	3000 acid.
	Potential 268 bbls., pump.
	COMPLETED

Map No. 46 Sec. 10 Twp. 20 R. 11WWell No. 4 StateDerby Oil

Company _____

Contractor _____

FIRST REPORT

SE SW

SECTION PLAT

_____ Ft. from N. Line

330 Ft. from S. Line330 Ft. from E. Line

_____ Ft. from W. Line

ZENITH POOL

Location _____

Rig up _____

Drilling and Remarks:

Pits

RECORD

Cased _____ in., _____ ft.

Sand _____

Gas _____

Oil _____

Total Depth _____

PRODUCTION

1st 24 hrs. Nat. _____

1st 24 hrs. after shot _____

Gas _____ Cu. Ft.

Dry Hole _____

Abandoned _____

Date

JAN 31 1940

19

S. J. LEWIS

Scout

Barton KANSAS

Map No. 46 Sec. 10 Twp. 20 R. 11WWell No. 4 StateDerby Oil

Company


CORRECTION

Contractor

SE SW

 Ft. from N. Line290 Ft. from S. Line170 Ft. from E. Line Ft. from W. Line

SECTION PLAT

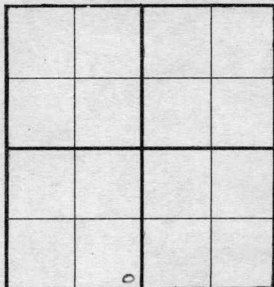Location Rig up

Drilling and Remarks:

Reported**330 x 330**

RECORD

Cased in., ft.Sand Gas Oil Total Depth

PRODUCTION

1st 24 hrs. Nat. 1st 24 hrs. after shot Gas Cu. Ft.Dry Hole Abandoned

Date

FEB 7 1940

19

S. J. LEWIS

Scout

KANSAS

Form 26—1M Bks.—2-29

Barton

Map No. 46 Sec. 10 Twp. 20 R. 11WWell No. 4 StateDerby Oil

Company

Contractor

COMPLETED

SE SW

SECTION PLAT

 Ft. from N. Line290 Ft. from S. Line170 Ft. from E. Line Ft. from W. Line

SILICA POOL

Location Rig up

Drilling and Remarks:

*Ar & 3287**4 1/2" @ 3288.**3000 acid**Pump 268 P.S.*

RECORD

Cased in., ft.Sand Gas Oil Total Depth 3297

PRODUCTION

1st 24 hrs. Nat. 1st 24 hrs. after shot Gas Cu. Ft.Dry Hole Abandoned

Date

MAR 27 1940 19

S. J. LEWIS

Scout