

Barton


KANSAS

Form 51-5M 5-37 Petrol

Section 11 Township 20 Range 11-W

Well No. 2 - Kowalsky

Company Stanolind

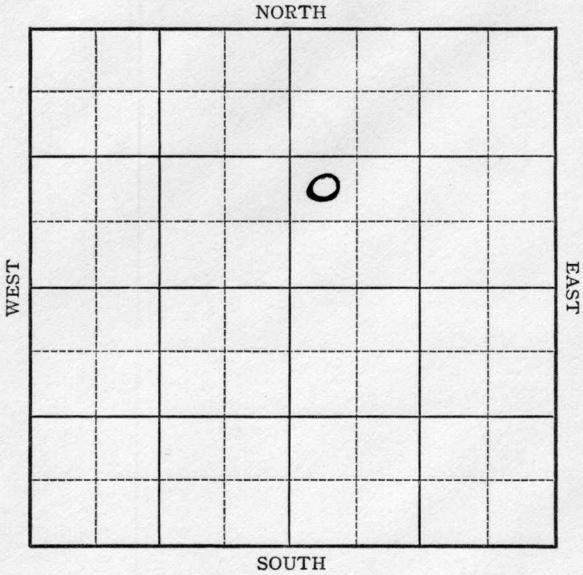

Sec. 11 Twp. 20 R. 11-W

Well No. #2 Kowalsky Farm

Stanolind Company


 Ft. from N. Line

990 Ft. from S. Line

 Ft. from E. Line

330 Ft. from W. Line

Elev. 1759

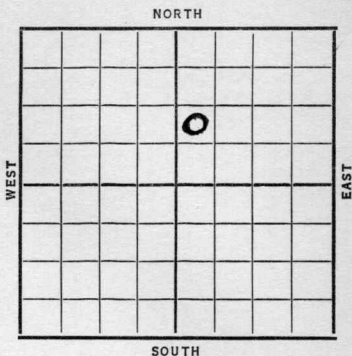

Date	REPORT
1937	
8/4	Mov. in Rot.
8/13	13" @ 187'. Anhy 501'.
	Drl g. 525'.
8/20	Drl g. 2810'.
8/28	Sil. & 6" @ 3279'.
	T.D. 3287'. Sat. Core.
	RUST.
9/3	" "
9/10	H.F.01 1 hr. Swab 83 BOPH
	2 hrs. On potential.
9/17	On potential.
9/22	Sil. 3279'.
	T.D. 3287'.
	Potential 2170 bbls. Nat.
	COMPLETED

Map No. _____ Sec. 11 Twp. 20 R. 11 W

Well No. 2-Kowalsky

Stanolind Company

Contractor _____

FIRST REPORT

SECTION PLAT

_____ Ft. from N. Line

990 Ft. from S. Line

_____ Ft. from E. Line

330 Ft. from W. Line

		0	

Location _____

Rig up _____

Drilling and Remarks:

mov. in Rot.

RECORD

Cased _____ in., _____ ft.

Sand _____

Gas _____

Oil _____

Total Depth _____

PRODUCTION

1st 24 hrs. Nat. _____

1st 24 hrs. after shot _____

Gas _____ Cu. Ft.

Dry Hole _____

Abandoned _____

Date

AUG 4 - 1937 19

H. D. Hatfield

Scout

Map No. _____ Sec. 11 Twp. 20 R. 11W

Well No. 2-Kowalsky

Stanolind Company

Contractor _____

SECTION PLAT

		0	

_____ Ft. from N. Line

990 Ft. from S. Line

_____ Ft. from E. Line

330 Ft. from W. Line

COMPLETED

RECORD

Location _____

Rig up _____

Drilling and Remarks:

*Potential
2170 bbls
Nat.*

Cased _____ in., _____ ft.

Sand Silicious 3279

Gas _____

Oil _____

Total Depth 3287

PRODUCTION

1st 24 hrs. Nat. _____

1st 24 hrs. after shot _____

Gas _____ Cu. Ft.

Dry Hole _____

Abandoned _____

Date

SEP 22 1937

19

H. D. Hatfield

Scout