
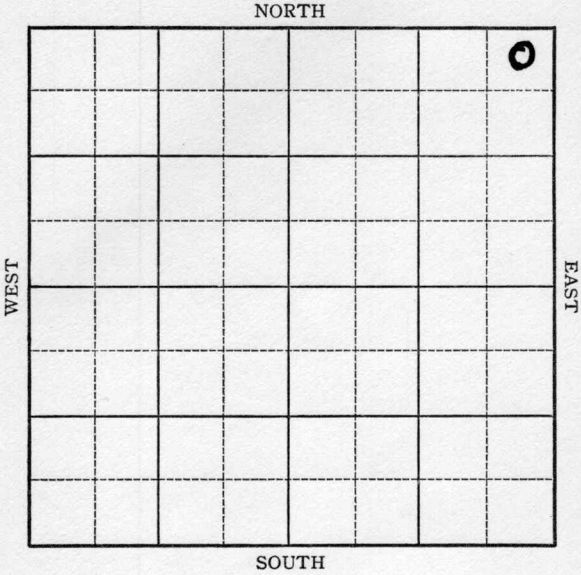


Section 11 Township 20 Range 11-W
Well No. 3 - Kowalsky
Company Stanolind

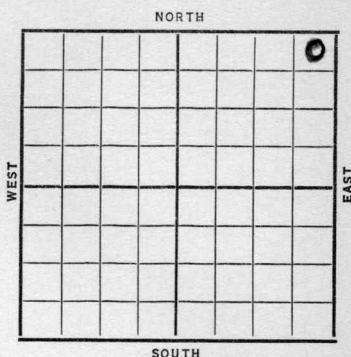

Sec. 11 Twp. 20 R. 11-WWell No. #3 Kowalsky Farm
Stanolind Company330 Ft. from N. Line Ft. from S. Line330 Ft. from E. Line Ft. from W. Line

Date	REPORT
1937	
8/18	B. R. R.
8/28	R. R.
9/3	13" @ 188'. Drlg. 1799'.
9/10	Coring 3273'.
9/17	Sil. 3278'. 6" @ 3279'.
	T.D. 3282'. WOC.
9/24	T.D. 3284' No oil. Coring.
10/2	At T.D. 3309'- Swb. 13 BOPH.
	T.D. 3311'. 1000 acid.
	Swab 40 B.O. in 2 hrs.
	2000 acid.
10/6	6" @ 3279'.
	Sil. 3278'.
	T.D. 3311'.
	3000 acid.
	Pot. 739 bbls.
	COMPLETED

Barton KANSASMap No. 46 Sec. 11 Twp. 20 R. 11 ^WWell No. 3-KowalskyStanolind Company

Contractor

FIRST REPORT

SECTION PLAT

			0

330 Ft. from N. Line

_____ Ft. from S. Line

330 Ft. from E. Line

_____ Ft. from W. Line

Location _____

Rig up _____

Drilling and Remarks:

B.R.R.

RECORD

Cased _____ in., _____ ft.

Sand _____

Gas _____

Oil _____

Total Depth _____

PRODUCTION

1st 24 hrs. Nat. _____

1st 24 hrs. after shot _____

Gas _____ Cu. Ft.

Dry Hole _____

Abandoned _____

Date

AUG 18 1937 19H. D. Hatfield Scout

Barton

KANSAS

Map No. _____ Sec. 11 Twp. 20 R. 11WWell No. 3 KowalskyStanolind Company

Contractor _____

COMPLETED

NE/C

SECTION PLAT

			0

330 Ft. from N. Line

_____ Ft. from S. Line

330 Ft. from E. Line

_____ Ft. from W. Line

Location _____

RECORD

Cased 6 in., 3279 ft.~~Sand~~ 511 3278

Gas _____

Oil _____

Total Depth 3311

PRODUCTION

1st 24 hrs. Nat. _____

1st 24 hrs. after shot _____

Gas y _____ Cu. Ft.

Dry Hole _____

Abandoned _____

Rig up _____

Drilling and Remarks:

3000 AcidPOT- 739

Date

OCT - 6 1937

19

H. D. Hatfield Scout