


Barton

KANSAS

SECTION 29 TOWNSHIP 18S RANGE 11W

WELL NO. #1 P. Kimpler

COMPANY Thunderbird

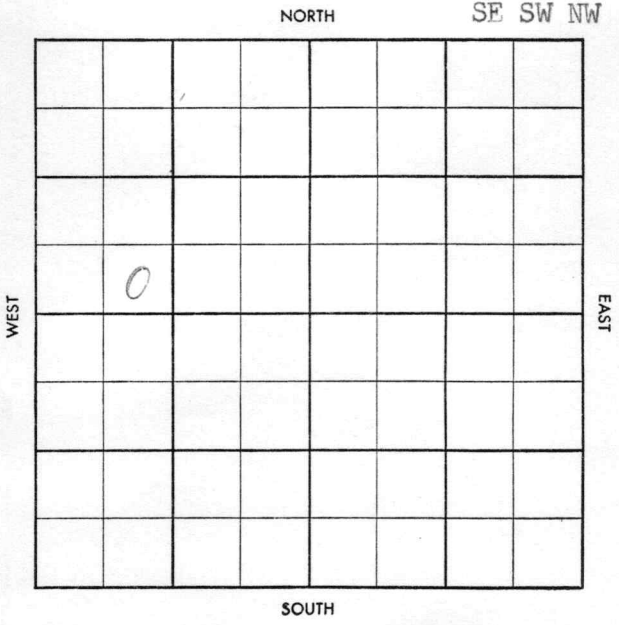



CO. Barton ELEV. 1833  
SEC. 29 TWP. 18 RGE. 11W  
COMPANY Thunderbird NO. 1

OCT 16 '57  
9  
ABANDONED  
OCT 1 1957

FARM P. Kimpler

LOC. SE SW NW

Tops	
Anhy.	677
H	3005
B1	3116
L	3129
C	3411
T	3455

GEOL. \_\_\_\_\_  
CONTR. Co. Tools  
POOL Feist Abd.  
SPUD 9-29-57  
8" @ 240, Drlg. 1515  
OCT 9 '57 DST 3154-  
3205 60" 15' M  
BHP 114 DST  
3285 - 3345 1 1/2  
30' M BHP 595

D 6A

CO.  
LSE.  
NO.  
SEC.  
TWP.  
RGE.