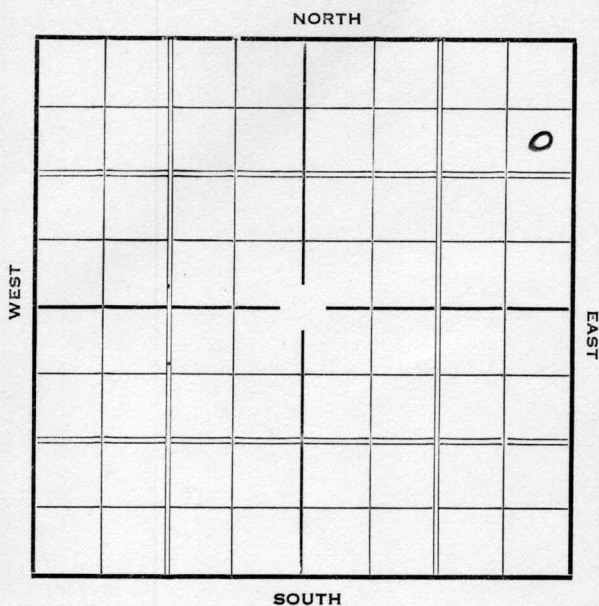


Section 11 Township 20 Range 11-WWell Number #5 KowalskyCompany Stanolind

Barton

KANSAS

Map No. _____ Sec. 11 Twp. 20 R. 11WWell No. 5 KowalskyStanolind

Company

Contractor

FIRST REPORT

SE NE NE

990 Ft. from N. Line

_____ Ft. from S. Line

330 Ft. from E. Line

_____ Ft. from W. Line

SECTION PLAT

			0

Location _____

Rig up _____

Drilling and Remarks:

RR

RECORD

Cased _____ in., _____ ft.

Sand _____

Gas _____

Oil _____

Total Depth _____

PRODUCTION

1st 24 hrs. Nat. _____

1st 24 hrs. after shot _____

Gas _____ Cu. Ft.

Dry Hole _____

Abandoned _____

Date

OCT 13 1937 19H. D. Hatfield Scout

Barton

KANSAS

Map No. _____ Sec. 11 Twp. 20 R. 11WWell No. 5 KowalskyStanolind Company

Contractor _____

COMPLETED

SE NE NE

990 Ft. from N. Line

_____ Ft. from S. Line

330 Ft. from E. Line

_____ Ft. from W. Line

SECTION PLAT

			0

Location _____

Rig up _____

Drilling and Remarks:

*2000 acid**POT-1020*

RECORD

Cased 6 in., 3279 ft.Sand 511 3279

Gas _____

Oil _____

Total Depth 3295

PRODUCTION

1st 24 hrs. Nat. _____

1st 24 hrs. after shot _____

Gas _____ Cu. Ft.

Dry Hole _____

Abandoned _____

Date

NOV 17 1937 19H. D. Hatfield Scout