


Section 11 Township 20 Range 11-W

Well No. 11 Kowalsky

Company Stanolind

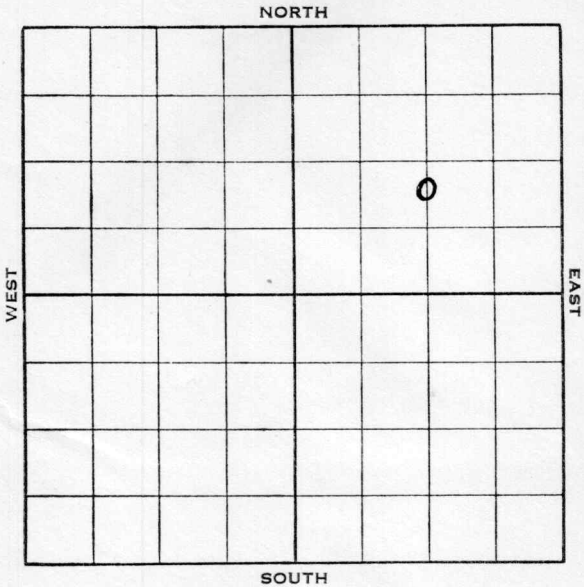

Barton

KANSAS

Map No. 46 Sec. 11 Twp. 20 R. 11WWell No. 11 Kowalsky

Stanolind

Company

Contractor

FIRST REPORT

C N L S $\frac{1}{2}$ NE

____ Ft. from N. Line

990 Ft. from S. Line1320 Ft. from E. Line

____ Ft. from W. Line

SECTION PLAT

			0

Location _____

Rig up _____

Drilling and Remarks:

BRR

RECORD

Cased _____ in., _____ ft.

Sand _____

Gas _____

Oil _____

Total Depth _____

PRODUCTION

1st 24 hrs. Nat. _____

1st 24 hrs. after shot _____

Gas _____ Cu. Ft.

Dry Hole _____

Abandoned _____

Date

OCT 5 - 1938 19

H. D. Hatfield Scout

Barton

KANSAS

Map No. _____ Sec. 11 Twp. 20 R. 11WWell No. 11 KowalskyStanolind

Company

Contractor

COMPLETED

C N L S $\frac{1}{2}$ NE

SECTION PLAT

		0	

_____ Ft. from N. Line

990 Ft. from S. Line1320 Ft. from E. Line

_____ Ft. from W. Line

Location _____

Rig up _____

Drilling and Remarks:

*2000 acid**POT 1991**65 wt*

RECORD

Cased 7 in., 3284 ft.Sand Arb 3282

Gas _____

Oil _____

Total Depth 3294

PRODUCTION

1st 24 hrs. Nat. _____

1st 24 hrs. after shot _____

Gas _____ Cu. Ft.

Dry Hole _____

Abandoned _____

Date

NOV 9 - 1938 19H. D. Hatfield

Scout