



Section 11 Township 20 Range 11-W
Well No. 8 Kowalsky
Company Stanolind

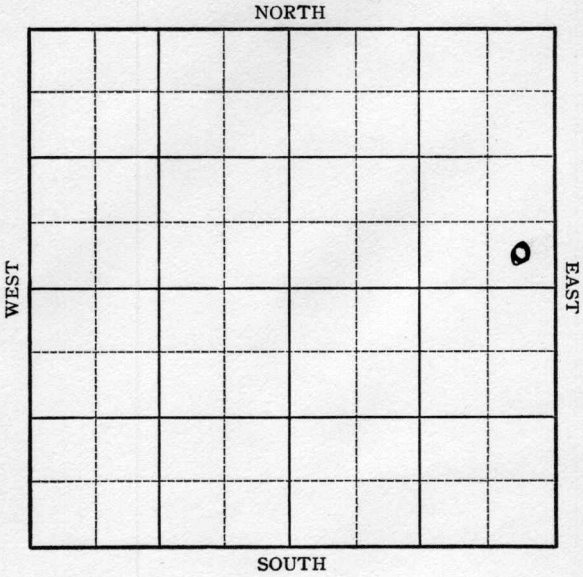

Sec. 11 Twp. 20 R. 11-WWell No. #8 Kowalsky FarmStanolind Company Ft. from N. Line330 Ft. from S. Line330 Ft. from E. Line Ft. from W. Line

Elev. 1764

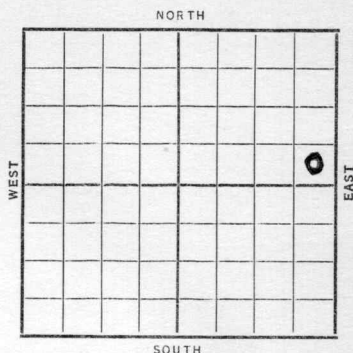

Date

REPORT

1937

12/15

B. R. R.

12/24

10" @ 200'. Drl g. 675'.

12/31

Arb. 3282 & 6". T.D. 3285'.

RUST. No shows reported.

1938

1/7

" " " "

1/12

6" @ 3282'.

Arb. 3282'.

T.D. 3285'.

Potential 2043 bbls., Nat.

COMPLETED

Barton KANSAS

Map No. 46 Sec. 11 Twp. 20 R. 11WWell No. 8 KowalskyStanolind Company

Contractor

FIRST REPORT

SE NE

 Ft. from N. Line330 Ft. from S. Line330 Ft. from E. Line Ft. from W. Line

SECTION PLAT

Location Rig up

Drilling and Remarks:

BRR

RECORD

Cased in., ft.Sand Gas Oil Total Depth

PRODUCTION

1st 24 hrs. Nat. 1st 24 hrs. after shot Gas Cu. Ft.Dry Hole Abandoned

Date

DEC 15 1937

19

H. D. Hatfield Scout

Barton KANSAS

Map No. 46 Sec. 11 Twp. 20 R. 11WWell No. 8 KowalskyStanolind Company

Contractor

COMPLETED

SE NE

 Ft. from N. Line330 Ft. from S. Line330 Ft. from E. Line Ft. from W. Line

SECTION PLAT

			0

Location Rig up

Drilling and Remarks:

Pet. 2043

nat

RECORD

Cased 6 in. 3282 ft.Sand arb. 3282Gas Oil Total Depth 3285

PRODUCTION

1st 24 hrs. Nat. 1st 24 hrs. after shot Gas Cu. Ft.Dry Hole Abandoned

Date

JAN 12 1938 19

H. D. Hatfield Scout